

Tunica

MISSISSIPPI BOARD OF WATER COMMISSIONERS

WATER WELL DRILLERS LOG

A 16  
2-17-67

*John ... 3/17/70 JCR*  
**COPIED**

Date: 2/17/ 19 67, Driller: Carloss Well Supply County Tunica  
(Name)

*Betty Carloss*

(1) Owner of Land: Bibbs, Inc.  
(Name)

Box 122, Tunica, Miss.  
(Address)

(2) Location: Polk Place Plantation  
Robinsonville, Mississippi  
16 35 NW  
miles of (direction) (Nearest Town)

(3) Topography: Flat  
(Hilly) (Flat) (Level)

(4) Purpose of Well: Domestic  
(Domestic Irrigation  
Municipal, Industrial, Other)

Description & Color of Materials Sand, Clay, Red Clay, Shell, etc.	Thick- ness Feet	Depth Feet
---	------------------------	---------------

<u>Top Soil &amp; Clay</u>	<u>30'</u>	<u>30'</u>
<u>Fine to Med. Sand</u>	<u>40'</u>	<u>70'</u>
<u>Coarse Sand</u>	<u>15'</u>	<u>85'</u>
<u>Coarse Sand &amp; Pea</u>	<u>20'</u>	<u>105'</u>
<u>Gravel</u>		

**COPIED**


Information upon completion of well:

- (1) Diameter 4" inches.
- (2) Total Depth 100' feet.
- (3) Water Level 18' feet below top of ground.
- (4) Cased to 74', Size 4".
- (5) Screen: Size 4", Length 21'.
- (6) Were any formations sealed against pollution?  
X yes, \_\_\_ no.

SEE REVERSE

If YES depth of formation Casing Cemented  
its entire length  
Why standard procedure

Drillers Remarks:

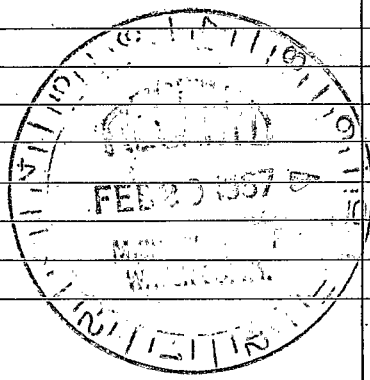

(Use Back Side)

Well No.

Owner:

Bibbs, Inc.

P. O. Box 122

Tunica, Mississippi