

TUNICA
A 17
5-10-74

MISSISSIPPI
BOARD OF WATER COMMISSIONERS
416 North State Street
Jackson, Mississippi 39201

CODED

WATER WELL DRILLERS LOG

5 10 19 74 Hester Drilling Co Tunica
date well completed firm name county well located

LANDOWNER: C.P. Owen
Tunica Miss
(mailing address)

description of formations encountered	from	to
CLAY	0	60
fine sand	60	75
coarse sand	75	120

WELL LOCATION:
sec. 36 T. 3 N. R. 11 E.
2 miles S.W. of Bowden
(distance) (direction) (nearest town)

WELL PURPOSE:
(home, irrigation, municipal, industrial)

- WELL COMPLETION DATA:
- (1) diameter (inches) 16
 - (2) total depth (feet) 120
 - (3) static water level (feet) 15 below top of ground.
 - (4) casing steel 80 (material) (depth)
16" (size) if telescope see back.
 - (5) screen 40' 80' (length) (depth to top)
16 (size) (material)
 - (6) pump 100 (HP) 3000 (yield gpm)
Electric (type power)
 - (7) electric log NO (yes or no)
 - (organization running log)
 - (8) how well bottom plugged Plastic


CODED

REGISTERED

DRILLERS REMARKS:

If well telescopes please
sketch and show depths.

GROUND LEVEL

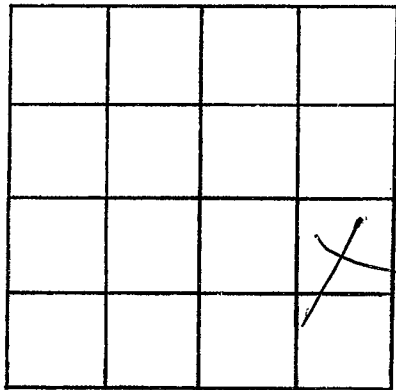

SECTION _____

Please indicate well location X.

ADDITIONAL INFORMATION

If more than one screen,
show locations of each on sketch.