

TUNICA
A 18
7-15-74

MISSISSIPPI
BOARD OF WATER COMMISSIONERS
416 North State Street
Jackson, Mississippi 39201

CODED

WATER WELL DRILLERS LOG

JULY 15 1974 WATSON Co. TUNICA
date well completed firm name county well located

LANDOWNER: ABBEY AND
LEATHERMAN
ROBINSONVILLE, MISS.
(mailing address)

description of formations encountered	from	to
GUMBO	0	11
BLACK MEALY SAND	11	33
BLUE CLAY	33	65
MED. SAND	65	74
COARSE SAND	74	88


WELL LOCATION:
sec. 28 T 3 N R 11 E
3 miles SW of ROBINSONVILLE
(distance) (direction) (nearest town)

WELL PURPOSE: FARM
(home, irrigation, municipal, industrial)

WELL COMPLETION DATA:

- (1) diameter (inches) 2"
- (2) total depth (feet) 88
- (3) static water level (feet) 4' below top of ground.
- (4) casing TOP 21' GAL. STEEL
PVC 78'
(material) (depth)
- (5) screen 10' 78'
(length) (depth to top)
2" PVC
(size) (material)
- (6) pump 2 60
(HP) (yield gpm)
- (7) electric log No
(yes or no)
- (8) how well bottom plugged PVC
PLUG

CODED

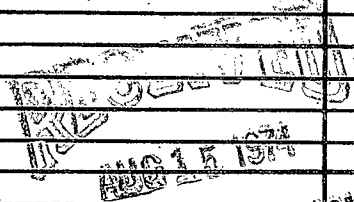


MISSISSIPPI BOARD OF WATER COMMISSIONERS

DRILLERS REMARKS:

If well telescopes please sketch and show depths.

GROUND LEVEL

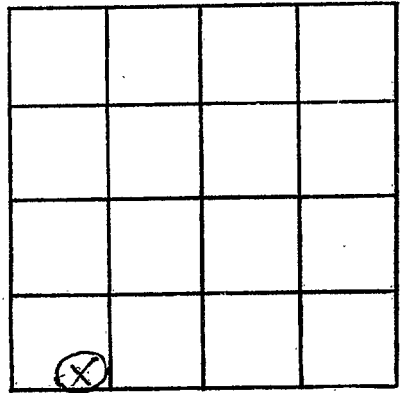

SECTION 28

Please indicate well location X.

ADDITIONAL INFORMATION

If more than one screen, show locations of each on sketch.