

TUNICA
A19
7-14-74

MISSISSIPPI
BOARD OF WATER COMMISSIONERS
416 North State Street
Jackson, Mississippi 39201

CODED

WATER WELL DRILLERS LOG

JULY 14 1974 WATSON Co. TUNICA
date well completed firm name county well located

LANDOWNER: ABBEY & LEATHERMAN
ROBINSONVILLE, Miss.

Description of formations encountered	from to	
	feet	feet
GUMBO	0	15
MEALY BLACK SAND	15	36
MED. TO FINE SAND	36	76
COARSE SAND	76	87

(mailing address)

WELL LOCATION:
sec. 21 T. 3 N. R. 11 E.
3 1/2 miles W of ROBINSONVILLE
(distance) (direction) (nearest town)

WELL PURPOSE: FARM
(home, irrigation, municipal, industrial)

WELL COMPLETION DATA:

- (1) diameter (inches) 2"
- (2) total depth (feet) ~~77~~ 87'
- (3) static water level (feet) 3' ^{below} _{above} top of ground
- (4) casing TOP 21 GAL. STEEL PVC 77' (material) (depth)
- (size) If telescope see back.
- (5) screen 10' ~~77~~ 77' (length) (depth to top)
2" PVC (size) (material)
- (6) pump 2 HP 60 (yield gpm)
- GASOLINE (type power)
- (7) electric log No (yes or no)
- (organization running log)
- (8) how well bottom plugged PVC PLDC.

CODED


RECEIVED
AUG 15 1974

MISS. BD. OF WATER COMMISSIONERS

DRILLERS REMARKS:

If well telescopes please sketch and show depths.

GROUND LEVEL

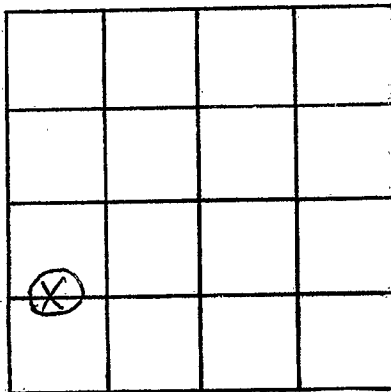

SECTION 21

Please indicate well location X.

ADDITIONAL INFORMATION

If more than one screen, show locations of each on sketch.