

TUNICA  
 CI-2768  
A25

MISSISSIPPI DEPARTMENT OF NATURAL RESOURCES  
 Bureau of Land and Water Resources  
 Southport Mall  
 P.O. Box 10631  
 Jackson, Mississippi 39209  
**WATER WELL DRILLERS LOG**

**CODED**

6/26 1984      LAYNE-CENTRAL CO.      TUNICA  
 date well completed      firm name      county well located

LANDOWNER:	description of formations encountered	from	to
RUSTY HODGES FARM			
TUNICA, MS	gravel	16	26
(mailing address)	coarse sand	26	50
	coarse sand gravel	50	122

**WELL LOCATION:**  
 sec. 25 T 3 S R 11 W  
 1 miles east of Bowdre  
 (distance) (direction) (nearest town)

**WELL PURPOSE:** irrigation  
 (home, irrigation, municipal, industrial)

**CODED**

**WELL COMPLETION DATA:**

(1) diameter (inches) 32"

(2) total depth (feet) 122'

(3) static water level (feet) 9' below top of ground.

(4) casing steel, 72' (material), (depth), 16" (size) if telescope see back.

(5) screen 50' (length), 72' (depth to top), 16" (size), st. steel (material)

(6) pump 100 (HP), 1800 (yield gpm), diesel (type power)

(7) electric log no (yes or no)

(organization running log)

(8) how well bottom plugged st. plate


**DRILLERS REMARKS:**

DEPT. OF NATURAL RESOURCES  
 BUREAU OF LAND & WATER RESOURCES

SEP 21 1984  
**RECEIVED**

If well telescopes please sketch and show depths.

GROUND LEVEL

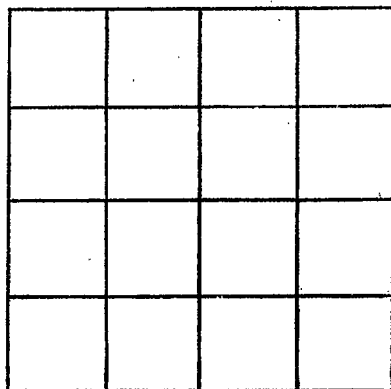

SECTION \_\_\_\_\_

Please indicate well location X.

ADDITIONAL INFORMATION

If more than one screen,  
show locations of each on sketch.