

TUNICA  
A 26

MISSISSIPPI  
BOARD OF WATER COMMISSIONERS  
416 North State Street  
Jackson, Mississippi 39201

WATER WELL DRILLERS LOG

12/16

1987 Fin Co. James

TUNICA

date well completed

firm name

county well located

LANDOWNER:

Aby J. Seathman  
Robinsonville main  
(mailing address)

description of formations encountered

from to

top soil	0	4
Clay	4	16
fin. sand	16	32
med sand	32	56
Sand & gravel	56	108

WELL LOCATION:


sec. 20 T 3 N R 11 E  
3 miles west of Robinsonville  
(distance) (direction) (nearest town)

WELL PURPOSE:

(home, irrigation, municipal, industrial)

WELL COMPLETION DATA:

- (1) diameter (inches) 16"
- (2) total depth (feet) 108
- (3) static water level (feet) \_\_\_\_\_ below/above top of ground.
- (4) casing ~~58~~ steel 58  
(material) (depth)  
16 (size) if telescope see back.
- (5) screen 58' 58'  
(length) (depth to top)  
16 (size) (material)
- (6) pump 125 2600  
(HP) (yield gpm)  
diesel (type power)
- (7) electric log no (yes or no)  
(organization running log)
- (8) how well bottom plugged well

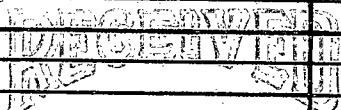

JAN 14 1988


Department of Natural Resources  
Bureau of Land & Water Resources

DRILLERS REMARKS:

~~CMG 1188~~  
08177CMG021188

If well telescopes please sketch and show depths.

GROUND LEVEL

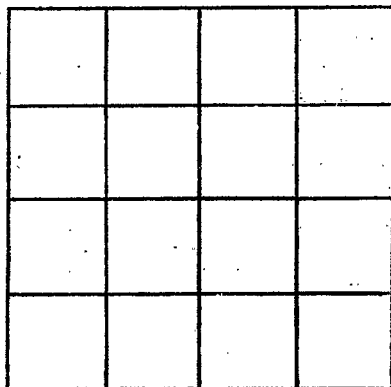

SECTION \_\_\_\_\_

Please indicate well location X.

ADDITIONAL INFORMATION

If more than one screen, show locations of each on sketch.