


TUNICA
A 27

MISSISSIPPI
BOARD OF WATER COMMISSIONERS
416 North State Street
Jackson, Mississippi 39201

WATER WELL DRILLERS LOG

12/28 date well completed 1987 Fine Co Driller firm name TUNICA county well located

LANDOWNER:	description of formations encountered	from	to
Ewers & Co	top soil	0	5
(mailing address)	Clay	5	18
WELL LOCATION: NW-NW corner	Thin sand	18	48
sec 17 T. 3 N R. 11 E	Med sand	48	60
1 1/2 miles N-E of Belmont ^{Bellevue}	Sand & gravel	60	100
(distance) (direction) (nearest town)	St Bellevueville		
WELL PURPOSE:			
(home, irrigation, municipal, industrial)			
WELL COMPLETION DATA:			
(1) diameter (inches) 12"			
(2) total depth (feet) 100'			
(3) static water level (feet) _____ below above top of ground.			
(4) casing Steel, 60' (material) (depth)			
12" if telescope see back. (size)			
(5) screen 40', 60' (length) (depth to top)			
12" steel (size) (material)			
(6) pump 40 HP, 600 (yield gpm)			
diesel (type power)			
(7) electric log NO (yes or no)			
(organization running log)			
(8) how well bottom plugged <u>2 1/2' of sand</u>			
DRILLERS REMARKS:			
CMG 021188			

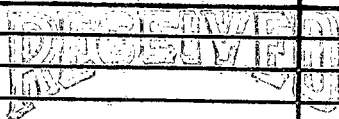

JAN 14 1988

Department of Natural Resources
Bureau of Land & Water Resources

If well telescopes please sketch and show depths.

GROUND LEVEL

SECTION _____

Please indicate well location X.

ADDITIONAL INFORMATION

If more than one screen,
show locations of each on sketch.