	STATE V	WELL REPORT				
County: TunicA	SIAL	Part 1	For Office Use Only:			
Permit #: GW-47985		riller's Log	Well #: <u>A 56</u>			
Driller: Delta Drilling		nent of Environmental Quality nd and Water Resources	Aquifer:			
	Р	.O. Box 2309	E-Log #:			
Date drilling completed: <u>5-8-14</u>		on, MS 39225-2309 601)961-5210				
	(601)360-0535 (fax)				
	State Law requires that this report be prepared by the license holder responsible for the work and filed with the Department at the above address within 30 days of completion of drilling of the well or borehole.					
Well Owner Informat	ion		hole Location			
(Landowner if borehole is not for $(A + b) = A$		Latitude: 34° 46 35 Lor	ngitude: <u>90° 20 04 -</u>			
Owner Name: <u>Malculm Ma</u>	0	Method of Lat/Long (check one	e): Conventional Survey,			
Mailing Address: 4690 Spring Place Cove		USGS quad, Hand-held GPS, Survey-grade GPS				
Olive Bronch, MS. 38654		USGS quad, Hand-neid GPS, Survey-grade GPS $A \overline{t} \overline{t} \overline{t} \overline{t} \overline{t} \overline{t} \overline{t} \overline{t}$				
			-			
City State	Zip Code	5 Miles North o				
Telephone No. ()		(Distance) (Direction)	(Nearest Town)			
Location of the source of any surface with the source of any surface with the source of any surface with the source of the sourc	ine used in drilling a	nd development: na Ray Density Sonic Neutro				
Seisn	nic Survey Other (describe)				
If drilling is not re	lated to water well c	onstruction, skip the remainde	r of this block			
Purpose of Well (circle all applicable):	Home Industrial	Public Supply Irrigation	Fish Culture			
Other (describe):			RV			
If a flowing well, method of flow regu	lation: Valve	Other (describe)	U			
Static Water Level:fee	t [above or below (circle one)] land surface Date measure	d: <u>5-8-14</u>			
Method of measurement (circle one)	Steel tape Electric	tape Air line Other (<i>describe</i>)	:			
Well depth: <u>120</u> Well grouted to a	a depth of:_ <u>/D</u> f	eet Type of grout (circle one)	: Neat Cement (Sentonite) Mix			
Casing length: <u>70</u> feet C	asing diameter:	//einches Type of	casing: <u>PUL</u>			
Screen length: <u>50</u> feet	Screen diameter:	14inches Type of	screen:			
Screen slot size: <u>032</u> inches	Setting depth:	From <u>70</u> feet t	o <u>/20</u> feet			
Type of completion (circle all applicat	le): Gravel packed	Underreamed Open hole	Natural Development			
Other (describe):						
Top of lap pipe or reduction in casing	:feet					
If teleso	coped or more than	one screen, describe on next pa	nge			

٠


.

County:	Tunich	7	
Permit #:	Gw-	47985	

.

The sketch below only required for water wells

If well telescopes, show depths on sketch.

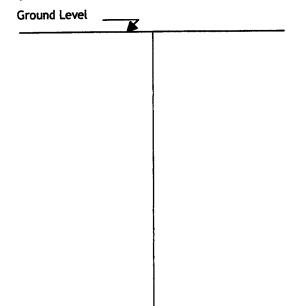

Description of formations encountered must be provided for all wells and boreholes, unless specifically exempted by regulations

Description of Formations Encountered	From (depth)	To (depth)
Cley	Ground level	45
fine scrol	46	58
Coorse sand	59	120
		l

If more than one screen, show location of each on sketch

Sketch the property layout and include the following:	
1) the well location 2) any permanent structures on the property that may aid in locating the well	
λ 3) any roads, power lines, or other items that may aid in locating the well	
A 4) north arrow	
	Received
	JUN 16 2014
	BY OLWR
	DIOLVAR
AKKobuth ibn Rol. Well	
TIKKOOMIF	
Landowner Name:	`
I HEREBY CERTIFY that the well/borehole was drilled, constructed, and completed in accorda requirements of the Mississippi Department of Environmental Quality and the Mississippi Depa if applicable, and state laws.	nce with all applicable rtment of Health regulations,
C. Shackley 2561 5-8-14 (. 1/14	lh
Print Name of Responsible Licensee and License No. Date Signat	ure of Ligensee
l	Form: OLWR-SWR-1A (4/13)

	STATE WELL REPORT			
County: TanizA	Part 2	For Office Use Only:		
Permit #: <u><u>GW- 47985</u></u>	Pump Installer's Completion Report			
Driller: Delta Dr. 11. ha	Mississippi Department of Environmental Quality Office of Land and Water Resources	Well #: <u>A 56</u>		
Date completed: <u>5-8-14</u>	P.O. Box 2309	Aquifer:		
Copy information from block on Part 1	Jackson, MS 39225-2309 (601)961-5210	Aquirer		
	(601) 360-0535 (fax)	L		
	d by a licensed water well contractor or a licensed pu parts filed with the Department at the above address v			
Well Owner Informati		Location		
Owner Name: Melcolm McClo.		ngitude: <u>90° 20 04</u>		
Mailing Address: 4690 Spr. Ma	Place Care Method of Lat/Long (check one	e): Conventional Survey, iPS, Survey-grade GPS		
Dive Branch Mr. 3865				
		35 T 35 R 1/W		
City State	Zip Code	Track		
Telephone No. ()	Zip Code <u>5</u> Miles <u>North</u> o (Distance) (Direction)	(Nearest Town)		
	Pump Type (circle one)			
Cubmamiki Turking Air Lift Control	ugal Flowing Well Jet Piston Rotary Other (de	rscribe):		
	-			
	Rated Pump Capacity:	Gallons Per Minute		
Is This Pump (circle one): New Re				
	Power Type (circle one)			
	Tractor PTO Windmill Other (<i>describe</i>):			
Horse Power Rating of Motor:	Setting Depth: <u>70</u> feet Number	r of Stages: <u> </u>		
	Pump Test Data for Non Flowing Well			
Date Well Tested:	Duration of Pump Test (minin	num 4 hours): hours		
Static Water Level (A): Fee	t Below Land Surface Pumping Water Level (B): _	Feet Below Land Surface		
Drawdown [(B) - (A)]:	Feet Below Land Surface Test Pumping Rate:	Gallons Per Minute		
Method of measurement (circle one): S	teel tape Electric tape Air line Other (describe):			
	Pump Test Data for Flowing Well			
Measured shut in head:feet	•			
Well vielded GPM with a	drawdown of feet after	_hours of pumping		
Meter Installation				
Me (como	Meter Serial Number:	W-DUNY7		
	Type of Meter: Sc			
	actor (AF x .001, gal x 1000, etc):			
	Meter installed by: Della Drilling			
Is This Meter (circle one): New Re		BYULW		
Important: By submitting the above in For agriculti	nformation you are certifying that this meter was instaural wells, a list of approved meters is on the MDEQ w	alled to manufacturer standards. vebsite.		
I HEREBY CERTIFY that the above state	ments are true to the best of my knowledge.			
A Stankle 20	5-8-14			
C. Shockley 25 Print Name of Pump Installer and Licer	ise No. (if applicable) Date Signa	ature of Pump Installer		
		Eorm: OI WP-SWP-1B (4/13)		

Form: OLWR-SWR-1B (4/13)