County: \overline{Iunia} Permit #: $\underline{CW} - \underline{47751}$ $\underline{AU} - \underline{11}$ Mississipp	ATE WELL REPORT Part 1 Driller's Log bi Department of Environmental Quality fice of Land and Water Resources P.O. Box 2309 Jackson, MS 39225-2309 (601)961-5210 (601)360-0535 (fax)	For Office Use Only: Well #:		
State Law requires that this report be prepare Department at the above address within 30 do				
Well Owner Information Well or Borehole Location				
(Landowner if borehole is not for a water w Owner Name: <u>Shea</u> Leathermen	Latitude: <u>34° 49</u> 00 Lon	ngitude: <u>90° 25 31</u>		
Mailing Address: Mana Bear UC	Method of Lat/Long (check one	Method of Lat/Long (check one): Conventional Survey,		
Mailing Address: <u>Incoma Dear acc</u>	USGS quad, Hand-held G	PS, Survey-grade GPS		
		13 T 35 R 12W		
Robinsonville, Ms. 38664 City State Zip	Code 7 Miles West o			
Telephone No. ()	(Distance) (Direction)	(Nearest Town)		
	Well / Borehole Data			
Seismic Survey	drilling and development: ic Gamma Ray Density Sonic Neutro	on Other: Ground Source Heat Pump		
Purpose of Well (circle all applicable): Home				
Other (describe):		JUN 16 2014		
If a flowing well, method of flow regulation: Val	ve Other (describe)	BY OI WE		
Static Water Level: 25feet [above orland surface Date measured:				
Method of measurement (circle one): Steel tape	Electric tape Air line Other (describe):		
Well depth: 105 Well grouted to a depth of: feet Type of grout (circle one): Neat Cement Bentonite Mix				
Casing length: <u>65</u> feet Casing diameter: <u>16</u> inches Type of casing: <u>PJC</u>				
Screen length: <u>40</u> feet Screen dia	meter: <u>16</u> inches Type of	screen:		
Screen slot size: 1032 inches Setting depth: From 65 feet to 105 feet				
Type of completion (circle all applicable). Gravel packed Underreamed Open hole Natural Development				
Other (describe):				
Top of lap pipe or reduction in casing:				
If telescoped or m	ore than one screen, describe on next p	age		

+


, .

County:	Tuniza
Permit #:	GW- 47751

	Fo	or Of	fice	Us	e (Inly	•
Well	#: ₋	A	5	7			

The sketch below only required for water wells

If well telescopes, show depths on sketch.

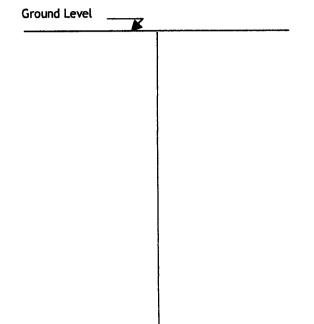

Description of formations encountered must be provided for all wells and boreholes, unless specifically exempted by regulations

Description of Formations Encountered	From (<i>depth</i>)	To (depth)
Clay	Ground level	38
•		
five scrol	39	46
Civerse send grovel	47	105
	L.m	· · · · · · · · · · · · · · · · · · ·
·		

If more than one screen, show location of each on sketch

Sketch the property layout an (1) the well location 2) any permanent structure 3) any roads, power lines 4) north arrow	d include the following: ures on the property that may aid in locating the well s, or other items that may aid in locating the property and t	he well
well	Cesito Strip Resort Blud.	
Golf course	Reserver District Ditter	Received JUN 16 2014 BY OLWR
Landowner Name:	1	
requirements of the Missis if applicable, and state la <i>C. Shackley</i>	e well/borehole was drilled, constructed, and comple ssippi Department of Environmental Quality and the M ws. 252 (E Licensee and License No. Date	eted in accordance with all applicable Assissippi Department of Health regulations, Signature of Locensee
FINE Name of Responsible		Form: OLWR-SWR-1A (4/13

STATE WE	LL REPORT	
Permit #: <u>Gw</u> -47761 Driller: <u>DcHa</u> <u>DcHa</u> <u>DcHa</u> <u>DcHa</u> <u>DcHa</u> <u>DcHa</u> <u>DcHa</u> Date completed: <u>5-4-14</u> <u>Copy information from block on Part 1</u> <u>Copy information from block on Part 1</u>	Part 2 s Completion Report and of Environmental Quality and Water Resources b. Box 2309 MS 39225-2309 1)961-5210	For Office Use Only: Well #: <u>A 57</u> Aquifer:
This part of the report must be completed by a licensed water w	360-0535 (fax) vell contractor or a licensed pum	p installer. A copy of Part 1
of the report must be attached and both parts filed with the De Well Owner Information	partment at the above address w Well Lo	
		gitude: <u>40° 25 31</u>
	Method of Lat/Long (check one)	
-		S, Survey-grade GPS
		3 T 35 R / 2W
City State Zip Code	7 Miles West of	Rob. hsonville
Telephone No. ()	(Distance) (Direction)	(Nearest Town)
	e (circle one)	
Submersible Turbine Air Lift Centrifugal Flowing Well		
Date Pump Installed: <u>5-4-14</u> Ra		Gallons Per Minute
Is This Pump (circle one); New Repaired Replacement		
	e (circle one)	
Electric Diesel Gasoline Natural Gas Tractor PTO Wind		
Horse Power Rating of Motor: <u>40</u> Setting Depth	et Number	of Stages:
-	or Non Flowing Well	
Date Well Tested:	-	um 4 hours): hours
Static Water Level (A): Feet Below Land Surface	Pumping Water Level (B):	Feet Below Land Surface
Drawdown [(B) - (A)]:Feet Below Land Surfa	ce Test Pumping Rate:	Gallons Per Minute
Method of measurement (circle one): Steel tape Electric tap		
•	for Flowing Well	
Measured shut in head:feet.	_	
Well yieldedGPM with a drawdown of	feet after	hours of pumping
	stallation	
Meter Manufacturer: <u>Mc (smeter</u>	Meter Serial Number:	3-06876
Meter Manufacturer: <u>Mc (smeter</u> Meter Model Number/Name: <u>MJ 308</u> Totalizer Register Unit and Multiplier Factor (AF x .001, gal >	Type of Meter:	208 Sadding
Totalizer Register Unit and Multiplier Factor (AF x .001, gal x	(1000, etc):	I ICCEIV
Totalizer Register Unit and Multiplier Factor (AF x .001, gal > Installation Date: $5 - 4 - 14$ Meter installed by:	Uetta Unilling	JUN 16 20
Is This Meter (circle one): New Repaired Replacemer		RV ALL
Important: By submitting the above information you are cen For agricultural wells, a list of app	tifying that this meter was instal roved meters is on the MDEQ w	lled to manufacturer sta nd the V ebsite.
I HEREBY CERTIFY that the above statements are true to the	best of my knowledge.	11/1
C. Shockley 2561	5-4-14	ture of Pump installer
Print Name of Pump Installer and License No. (if applicable)	Date Signa	Cure of Pump Installer

4

•

Form: OLWR-SWR-1B (4/13)