

TUNICA
B4
11-10-73

MISSISSIPPI
BOARD OF WATER COMMISSIONERS
416 North State Street
Jackson, Mississippi 39201

CODED

WATER WELL DRILLERS LOG

11-10-73 19 Hester Drilling Co Tunica
date well completed firm name county well located

LANDOWNER: Charles Beard
Tunica Miss
(mailing address)

description of formations encountered	from	to
<u>CLAY</u>	<u>0</u>	<u>50</u>
<u>COARSE SAND & GRAVEL</u>	<u>50</u>	<u>111</u>

WELL LOCATION:
sec. 2 T. 3 N. R. 10 E.
5 miles N of Leitchland
(distance) (direction) (nearest town)

WELL PURPOSE:
(home, irrigation, municipal, industrial)

WELL COMPLETION DATA:

(1) diameter (inches) 16

(2) total depth (feet) 111

(3) static water level (feet) 13 below above top of ground.

(4) casing steel 2 7/8"
(material) (depth)
16 if telescope see back.
(size)

(5) screen 40ft 71
(length) (depth to top)
16 steel
(size) (material)

(6) pump 50 3000
(HP) (yield gpm)
Electric
(type power)

(7) electric log NO
(yes or no)

CODED

(organization running log)


(8) how well bottom plugged steel plates

DRILLERS REMARKS:

NO
DEC 7
1973

If well telescopes please sketch and show depths.

GROUND LEVEL

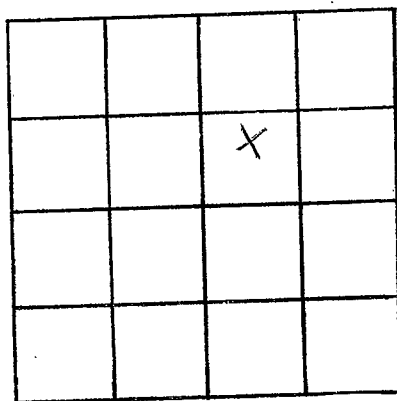

SECTION 2

Please indicate well location X.

ADDITIONAL INFORMATION

If more than one screen,
show locations of each on sketch.