

TUNICA

B 18

6-1-61

WATER WELL DRILLERS LOG

9/6/61

E-300

CODED TUNICA

Date: June 1, 19 61, Driller: Layne-Central Company County DeSoto
(Name)

(1) Owner of Land: Wallace M. Graves

(Name)

Lake Cormorant, Mississippi

(Address)

(2) Location: 1/4, 1/4, Sec. 10? T25R10W

2 miles north, of Banks

(distance) (direction) (Nearest Town)

(3) Topography: flat

(Hilly) (Flat) (Level)

(4) Purpose of Well: irrigation

(Domestic Irrigation
Municipal, Industrial, Other)

Information upon completion of well:

(1) Diameter 16 inches.

(2) Total Depth 105 feet.

(3) Water Level 1'-6" feet below top of ground.

(4) Cased to 55', Size 16"

(5) Screen: Size 16", Length 50'

(6) Were any formations sealed against pollution?

no yes, no no.

If YES depth of formation _____

Why _____

Drillers Remarks: _____

Description & Color of Materials
Sand, Clay, Red Clay, Shell, etc.

Thick-
ness
Feet

Depth
Feet

Clay

44

44

Coarse sand

51


95

Coarse sand & pea gravel

10

105

CODED

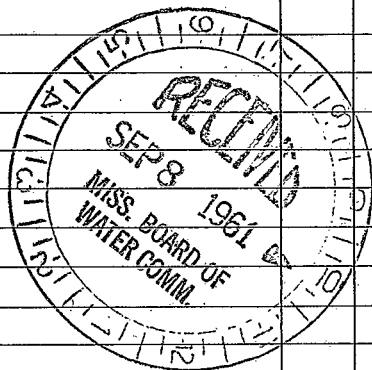

(Use Back Side)

Well No.

