

TUNICA MISSISSIPPI BOARD OF WATER COMMISSIONERS

B 19
8-7-63

WATER WELL DRILLERS LOG

8/5/63
CODED

Date: August 7, 1963, Driller: Layne-Central Company County Tunica
(Name)

Co.	Description & Color of Materials Sand, Clay, Red Clay, Shell, etc.	Thick- ness Feet	Depth Feet
(1) Owner of Land: <u>Ramsay-Austin Planting</u> Location - <u>Robinsonville, Miss.</u> <u>Memphis, Tennessee</u> (Address)	<u>Clay</u>	<u>38</u>	<u>38</u>
	<u>Coarse sand</u>	<u>20</u>	<u>58</u>
	<u>Coarse sand, pea gravel</u>	<u>54</u>	<u>112</u>
(2) Location: <u>1/4</u> , <u>1/4</u> , Sec. <u>21 T35R10W</u> <u>3</u> miles <u>east</u> , of <u>Robinsonville</u> (distance) (direction) (Nearest Town)	<u>Fine sand</u>		<u>112</u>
(3) Topography: <u>flat</u> (Hilly) (Flat) (Level)			
(4) Purpose of Well: <u>irrigation</u> (Domestic Irrigation Municipal, Industrial, Other)			

CODED


Information upon completion of well:

- (1) Diameter 16 inches.
- (2) Total Depth 112 feet.
- (3) Water Level 17' - 1" feet below top of ground.
- (4) Cased to 62', Size 16"
- (5) Screen: Size 16", Length 50'
- (6) Were any formations sealed against pollution?
no yes, no no.

If YES depth of formation _____

Why _____

Drillers Remarks: _____

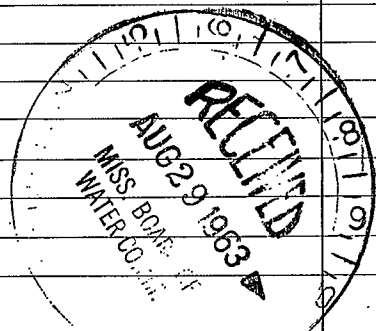

(Use Back Side)

Well No.

1950