

MISSISSIPPI
BOARD OF WATER COMMISSIONERS
416 North State Street
Jackson, Mississippi 39201

CODED

WATER WELL DRILLERS LOG

Tunica
B21
3-67

3/31 date well completed *1967 Watson Co.* firm name *Tunica* county well located

LANDOWNER: *A.M. Dye*
Lake Cormorant, Miss
(mailing address)

description of formations encountered	from	to
<i>Sandy loam</i>	<i>0</i>	<i>8</i>
<i>Gumbo</i>	<i>8</i>	<i>30</i>
<i>Fine Hard Sand</i>	<i>30</i>	<i>55</i>
<i>Med. Sand</i>	<i>55</i>	<i>80</i>
<i>Coarse Sand</i>	<i>80</i>	<i>93</i>

WELL LOCATION:
sec. *9* T. *3* N. R. *10* E.
2 miles *S.* of *De Soto* (nearest town)
West side Hwy. 61 (direction)
WELL PURPOSE: *Farm*
(home, irrigation, municipal, industrial)

WELL COMPLETION DATA:

(1) diameter (inches) *3"*

(2) total depth (feet) *93' 6"*

(3) static water level (feet) *18* below above top of ground.

(4) casing *galv. pipe 84' 2"*
(material) (depth)
If telescope see back.
(size)


(5) screen *6'*
(length) (depth to top)
#60 *Danze Point*
(size) (material)

(6) pump *1 H.P.* *Not tested*
(HP) (yield gpm)
Electric
(type power)

(7) electric log *no*
(yes or no)
(organization running log)

(8) how well bottom plugged *plug*


CODED

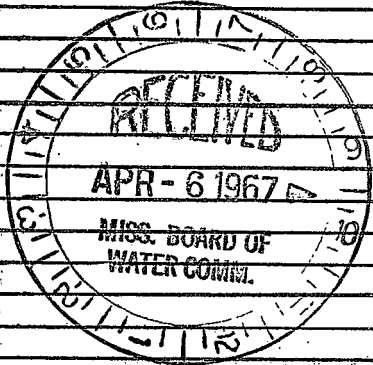

DRILLERS REMARKS:

If well telescopes please sketch and show depths.

GROUND LEVEL

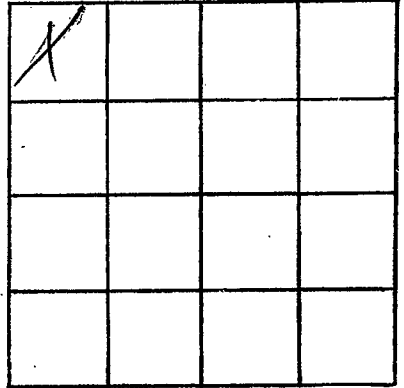

SECTION 9

Please indicate well location X.

ADDITIONAL INFORMATION

If more than one screen,
show locations of each on sketch.