

Junica
B22
9-67

MISSISSIPPI
 BOARD OF WATER COMMISSIONERS
 416 North State Street
 Jackson, Mississippi 39201

CODED

WATER WELL DRILLERS LOG

Sept 8 1967 Shelby Newman Junica
 date well completed firm name county well located

LANDOWNER: Robert Johnson
Robertsonville Miss
 (mailing address)

description of formations encountered	from	to
<u>Black Clay</u>	<u>0</u>	<u>10</u>
<u>Sandy</u>	<u>10</u>	<u>75</u>
<u>Clear Gray Sand</u>	<u>75</u>	<u>90</u>

WELL LOCATION:
 sec. 16 T. 2 N. R. 10 E.
2 miles East of Robertsonville Miss
 (distance) (direction) (nearest town)

WELL PURPOSE: Home
 (home, irrigation, municipal, industrial)

WELL COMPLETION DATA:

- (1) diameter (inches) 2
- (2) total depth (feet) 90
- (3) static water level (feet) 22 below top of ground.
- (4) casing Galvanized (material) (depth)

CODED

- (5) screen left Stair Steel Strainer (length) (depth to top)

- (6) pump 1-1/2" Jet (material) (HP) 1.0 (yield gpm)
- Electric (type power)

- (7) electric log No (yes or no)
- No (organization running log)


- (8) how well bottom plugged Pushed Seal

DRILLERS REMARKS:



If well telescopes please sketch and show depths.

GROUND LEVEL

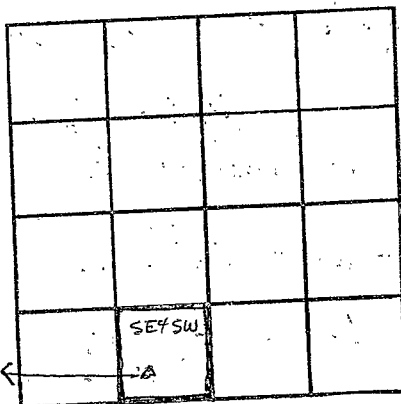

well ←

SECTION 16

Please indicate well location X.

ADDITIONAL INFORMATION

If more than one screen, show locations of each on sketch.