

Juniata
 B 27
 C-68

MISSISSIPPI
 BOARD OF WATER COMMISSIONERS
 416 North State Street
 Jackson, Mississippi 39201

CODED

WATER WELL DRILLERS LOG

June 28 1968 S. Hilby, Raymond Juniata
 date well completed firm name county well located

LANDOWNER: Herb Johnson
Banks, Miss.
 (mailing address)

description of formations encountered	from	to
<u>Blair Clay</u>	<u>0</u>	<u>20</u>
<u>Sand</u>	<u>20</u>	<u>80</u>
<u>Clear coarse sand</u>	<u>80</u>	<u>91</u>

WELL LOCATION:
 sec 26 T 3 N R 10 E
2 miles S of Banks
 (distance) (direction) (nearest town)

WELL PURPOSE:
 (home, irrigation, municipal, industrial)

WELL COMPLETION DATA:

- diameter (inches) 2
- total depth (feet) 91
- static water level (feet) 46 below top of ground.
- casing Galvanneal 8 1/2"
 (material) (depth)
 _____ if telescope see back.
 (size)
- screen 5 1/4"
 (length) (depth to top)
1 1/2" Stainless Steel
 (size) (material)
- pump 1 1/4
 (HP) (yield gpm)
Electric
 (type power)
- electric log no
 (yes or no)
no
 (organization running log)
- how well bottom plugged Rubber seal

CODED

DRILLERS REMARKS:


JUL 12 1968
 MISS. BOARD OF
 WATER COMMISSIONERS

Please send me a Log Book

If well telescopes please sketch and show depths.

GROUND LEVEL

well

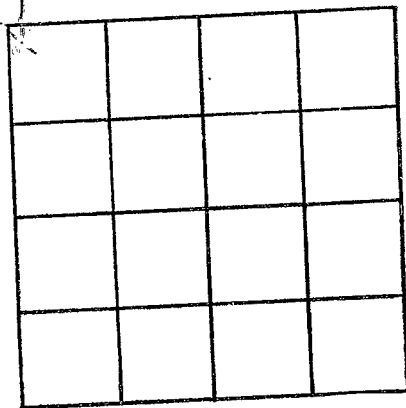

SECTION 24

Please indicate well location X.

ADDITIONAL INFORMATION

If more than one screen,
show locations of each on sketch.