

TUNICA  
B 28  
9-22-73

MISSISSIPPI  
BOARD OF WATER COMMISSIONERS  
416 North State Street  
Jackson, Mississippi 39201

CODED

WATER WELL DRILLERS LOG

9-22 1973 HESTER Drilling Tunica  
date well completed firm name county well located

LANDOWNER: T.E. Swindol

description of formations encountered

from

to

Robinsonville, Miss

clay	0	38
fine sand	38	49
coarse sand & gravel	49	91

(mailing address)

WELL LOCATION:

sec. 13 T 3 N R 10 E  
1 miles SE of Banks  
(distance) (direction) (nearest town)

WELL PURPOSE: Irrigation  
(home, irrigation, municipal, industrial)

WELL COMPLETION DATA:

- (1) diameter (inches) 16"
- (2) total depth (feet) 91
- (3) static water level (feet) 12 below top of ground
- (4) casing steel, 51 (material) (depth)  
16 (size) if telescope see back.
- (5) screen 40ft, 51 (length) (depth to top)  
16, steel (size) (material)
- (6) pump 50 (HP) 2,800 (yield gpm)  
electric (type power)
- (7) electric log no (yes or no)

CODED

(organization running log)

(8) how well bottom plugged steel plate

SEP 29 1973


DRILLERS REMARKS:

work

MISSISSIPPI  
BOARD OF WATER COMMISSIONERS  
JACKSON, MISSISSIPPI

If well telescopes please sketch and show depths.

GROUND LEVEL

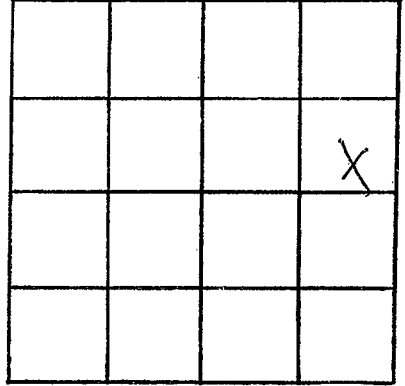

SECTION 14

Please indicate well location X.

ADDITIONAL INFORMATION

If more than one screen, show locations of each on sketch.

27