

TUNICA
 B 29
 9-28-73

MISSISSIPPI
 BOARD OF WATER COMMISSIONERS
 416 North State Street
 Jackson, Mississippi 39201

CODED

WATER WELL DRILLERS LOG

9-28 1973 Western Drilling Co. Tunica
 date well completed firm name county well located

LANDOWNER: T. E. Swardal
Robinsonville,
Miss
 (mailing address)

description of formations encountered	from	to
<u>clay</u>	<u>0</u>	<u>40</u>
<u>fine sand</u>	<u>40</u>	<u>100</u>
<u>coarse sand gravel</u>	<u>100</u>	<u>103</u>

WELL LOCATION:
 sec. 15 T 3 N R 10 E
1 miles S.W. of BANK
 (distance) (direction) (nearest town)

WELL PURPOSE: irrigation
 (home, irrigation, municipal, industrial)

- WELL COMPLETION DATA:
- (1) diameter (inches) 16"
 - (2) total depth (feet) 103
 - (3) static water level (feet) 12 below above top of ground.
 - (4) casing steel, 18
 (material) (depth)
16"
 (size) if telescope see back.
 - (5) screen 40, 63
 (length) (depth to top)
16", steel
 (size) (material)
 - (6) pump 60 3000
 (HP) (yield gpm)
direct
 (type power)
 - (7) electric log no
 (yes or no)
 - (organization running log)
 - (8) how well bottom plugged

CODED


SEP 29 1973

DRILLERS REMARKS:
flow

MISSISSIPPI BOARD OF WATER COMMISSIONERS
 JACKSON, MISSISSIPPI

If well telescopes please sketch and show depths.

GROUND LEVEL

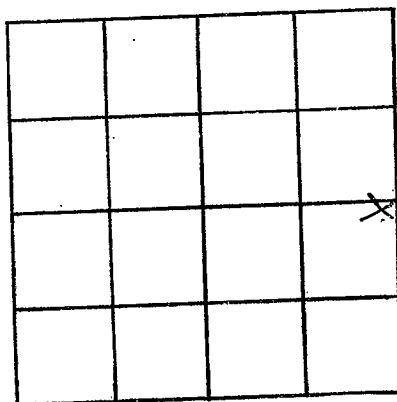

SECTION _____

Please indicate well location X.

ADDITIONAL INFORMATION

If more than one screen, show locations of each on sketch.