

Tunica
B 30
10-28-68

MISSISSIPPI
 BOARD OF WATER COMMISSIONERS
 416 North State Street
 Jackson, Mississippi 39201

CODED
 11/20/68
 Jm

WATER WELL DRILLERS LOG

CODED

October 29, 1968 Layne-Central Company Tunica
 date well completed firm name county well located

LANDOWNER: Thomas R. Crews	description of formations encountered	from	to
Jackson, Mississippi (mailing address)			
WELL LOCATION:	Coarse sand, gravel	28	50
sec. <u>35</u> T <u>3</u> S R <u>10</u> W	Gravel, pea gravel, sand	50	105
<u>4</u> miles south of Banks, Miss.	Clay	105	
(distance) (direction) (nearest town)			
WELL PURPOSE: irrigation (home, irrigation, municipal, industrial)			
WELL COMPLETION DATA:			
(1) diameter (inches) <u>16</u>			
(2) total depth (feet) <u>105</u>			
(3) static water level (feet) <u>10</u> above top of ground.			
(4) casing <u>steel</u> , <u>55'</u> (material), (depth) <u>16"</u> if telescope see back. (size)			
(5) screen <u>50'</u> , <u>105'</u> (length), (depth to top) <u>16"</u> , <u>Armco</u> (size), (material)			
HP <u>not available</u> <u>2400</u> (6) pump (HP), (yield gpm) <u>electric</u> (type power)			
(7) electric log <u>no</u> (yes or no) (organization running log)			
(8) how well bottom plugged <u>plate</u>			
DRILLERS REMARKS: Customer furnishes pumping equipment.			


CODED

NOV 28 1968

MISS. Bd. of WATER CONTROL

If well telescopes please sketch and show depths.

GROUND LEVEL

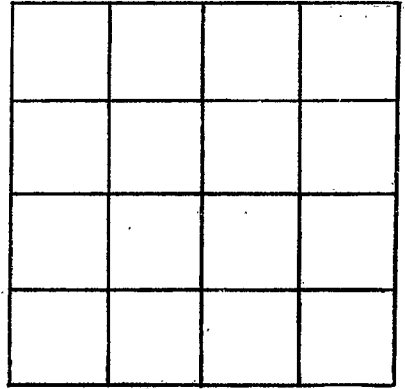

SECTION 35

Please indicate well location X.

ADDITIONAL INFORMATION

If more than one screen,
show locations of each on sketch.