

CODED

11/20/68  
*[Signature]*

CODED

Tunica  
B31  
10-26-68

MISSISSIPPI  
BOARD OF WATER COMMISSIONERS  
416 North State Street  
Jackson, Mississippi 39201  
WATER WELL DRILLERS LOG

October 26, 19 68 Layne-Central Company Tunica  
date well completed firm name county well located

LANDOWNER: <u>Battle B. Ewing</u>	description of formations encountered	from	to
<u>Robinsonville, Mississippi</u> (mailing address)			
	Clay balls	12	44
	Coarse sand, pea gravel	44	82
	Clay	82	
<b>WELL LOCATION:</b> <u>SE 1/4 SE 1/4</u> sec <u>24</u> T <u>3</u> N R <u>10</u> E S W <u>5</u> miles <u>SE</u> of <u>Banks, Miss.</u> (distance) (direction) (nearest town)			
<b>WELL PURPOSE:</b> <u>irrigation</u> (home, irrigation, municipal, industrial)			
<b>WELL COMPLETION DATA:</b>			
(1) diameter (inches) <u>16</u>			
(2) total depth (feet) <u>82</u>			
(3) static water level (feet) <u>6</u> <del>xxxxxx</del> above top of ground.			
(4) casing <u>steel</u> <u>42'</u> (material) (depth) <u>16"</u> if telescope see back. (size)			
(5) screen <u>40'</u> <u>82'</u> (length) (depth to top) <u>16"</u> <u>Armco</u> (size) (material)			
HP <u>not available</u>			
(6) pump <u>1800</u> (HP) (yield gpm)			
<u>electric</u> (type power)			
(7) electric log <u>no</u> (yes or no)			
<u>(organization running log)</u>			
(8) how well bottom plugged <u>plate</u>			
<b>DRILLERS REMARKS:</b> Customer furnishes pumping equipment.			

CODED


CODED

NOV 28 1968

MISS. DE. OF  
WATER CONTROL

If well telescopes please sketch and show depths.

GROUND LEVEL

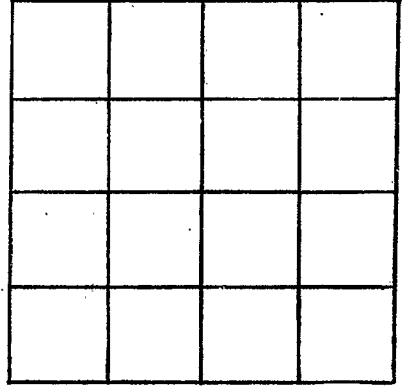

SECTION 24

Please indicate well location X.

ADDITIONAL INFORMATION

If more than one screen,  
show locations of each on sketch.