

Returned 6/20/69  
 Rev'd back  
 9/15/69  
 6/13/69  
 CODED

TUNICA  
 B 32  
 6-5-69

MISSISSIPPI  
 BOARD OF WATER COMMISSIONERS  
 416 North State Street  
 Jackson, Mississippi 39201  
 WATER WELL DRILLERS LOG

CODED

June 5, 1969 Layne-Central Company Tunica  
 date well completed firm name county well located

LANDOWNER: S. R. Phebus  
 Banks, Mississippi  
 (mailing address)  
 WELL LOCATION:  
 sec. 12 T 3 N R 10 E  
 S W  
 1 miles east of Banks  
 (distance) (direction) (nearest town)

description of formations encountered	from	to
Clay	0	37
Coarse sand, pea gravel	37	77
Coarse sand, gravel	77	101
Pink clay	101	102

WELL PURPOSE: irrigation  
 (home, irrigation, municipal, industrial)

WELL COMPLETION DATA:

- (1) diameter (inches) 16
- (2) total depth (feet) 102
- (3) static water level (feet) 4' 1" above top of ground.
- (4) casing steel, 52' (material), (depth)  
 16" (size) if telescope see back.
- (5) screen 50', 102' (length), (depth to top)  
 16" (size), Armco (material)
- (6) pump 50 (HP), 2400 (yield gpm)  
 electric (type power)
- (7) electric log no (yes or no)  
 (organization running log)
- (8) how well bottom plugged plate

CODED


JUN 17 1969

DRILLERS REMARKS:

MISSISSIPPI BOARD OF WATER COMMISSIONERS  
 JACKSON, MISSISSIPPI

If well telescopes please sketch and show depths.

GROUND LEVEL

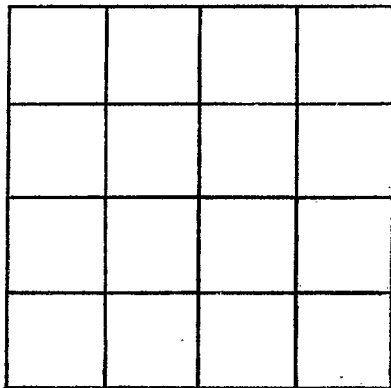

SECTION \_\_\_\_\_

Please indicate well location X.

ADDITIONAL INFORMATION

If more than one screen,  
show locations of each on sketch.