

**CODED**

MISSISSIPPI  
BOARD OF WATER COMMISSIONERS  
416 North State Street  
Jackson, Mississippi 39201

7/28/70  
JH  
08120

Tunica  
B34  
7-9-70

**WATER WELL DRILLERS LOG**

July 9, 1970 SINGER-Layne Central Division  
date well completed firm name Tunica county well located

LANDOWNER: Wallace & Jimmy Graves	description of formations encountered	from	to
Lake Cormorant, Mississippi			
Rector, Arkansas	Fine sand	8	20
(mailing address)	Clay	20	24
	Coarse sand	24	35
	Coarse sand, pea gravel	35	60
	Coarse sand, gravel	60	96

**WELL LOCATION:**

sec. 2 T. 3 R. 10  
6 miles south of Lake Cormorant  
(distance) (direction) (nearest town)

**WELL PURPOSE:** irrigation  
(home, irrigation, municipal, industrial)

**WELL COMPLETION DATA:**

- (1) diameter (inches) 16
- (2) total depth (feet) 96
- (3) static water level (feet) 9' below top of ground.
- (4) casing steel 46' (material), (depth)  
16" (size) if telescope see back.
- (5) screen 50' 96' (length), (depth to top)  
16" (size), Armco (material)
- (6) pump 30 2400 (HP), (yield gpm)  
electric (type power)
- (7) electric log no (yes or no)  
(organization running log)
- (8) how well bottom plugged plate


**CODED**

III 30 1970

DRILLERS REMARKS:

If well telescopes please sketch and show depths.

GROUND LEVEL

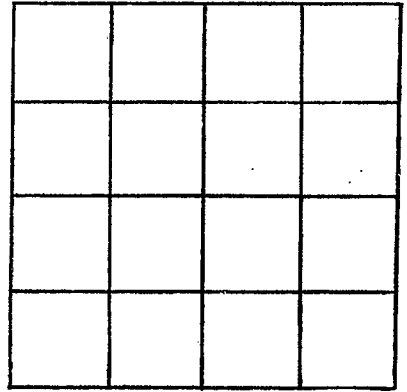

SECTION \_\_\_\_\_

Please indicate well location X.

ADDITIONAL INFORMATION

If more than one screen,  
show locations of each on sketch.