

TUNICA
B 35
9-27-70

MISSISSIPPI
BOARD OF WATER COMMISSIONERS
416 North State Street
Jackson, Mississippi 39201

CODED

WATER WELL DRILLERS LOG

9-27 1970 Nester Drilling Co Tunica
date well completed firm name county well located

LANDOWNER: Big 6 Farms
William Canadock Jr.
Memphis Tenn
(mailing address)

description of formations encountered	from	to
Clay <u>Clay</u>	0	15
<u>FINE SAND</u>	15	50
<u>CORR. SAND GRAIN</u>	50	104

WELL LOCATION:
sec. 25 T. 3 N. R. 10 E
5 miles Southwest of Brant
(distance) (direction) (nearest town)

WELL PURPOSE: Domestic
(home, irrigation, municipal, industrial)

- WELL COMPLETION DATA:
- (1) diameter (inches) 12"
 - (2) total depth (feet) 104 ft.
 - (3) static water level (feet) 22 below/above top of ground.
 - (4) casing steel, 64 ft. (material) (depth)
12 if telescope see back. (size)
 - (5) screen 40, 104 ft. (length) (depth to top)
12, steel (size) (material)
 - (6) pump 40, 2000 (HP) (yield gpm)
Direct (type power)
 - (7) electric log _____ (yes or no)

CODED

(organization running log)

(8) how well bottom plugged Steel Plate


OCT 8 1970

DRILLERS REMARKS:

MISS. BD. OF
WATER COMM.

If well telescopes please sketch and show depths.

GROUND LEVEL

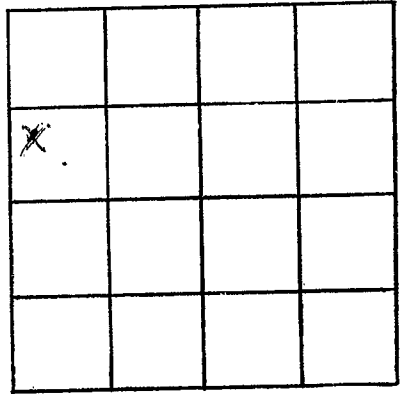

SECTION 25

Please indicate well location X.

ADDITIONAL INFORMATION

If more than one screen,
show locations of each on sketch.