

TUNICA  
B 36  
2-27-71

MISSISSIPPI  
BOARD OF WATER COMMISSIONERS  
416 North State Street  
Jackson, Mississippi 39201

**CODED**

WATER WELL DRILLERS LOG

Jan 4/27/71  
Ord. 5/14/71

date well completed 19 FEB 27 firm name Hester Drilling Co county well located Tunica

LANDOWNER: T.E. Swandoll  
Tunica Miss  
(mailing address)

| description of formations encountered | from      | to         |
|---------------------------------------|-----------|------------|
| <u>Blue clay</u>                      | <u>0</u>  | <u>47</u>  |
| <u>COARSE Sand</u>                    | <u>47</u> | <u>103</u> |

WELL LOCATION:  
sec 12 T 36 N R 10 E  
2 miles NE of BANKS  
(distance) (direction) (nearest town)

WELL PURPOSE:  
(home, irrigation, municipal, industrial)

**CODED**

WELL COMPLETION DATA:

(1) diameter (inches) 16"

(2) total depth (feet) 103

(3) static water level (feet) 3 below/above top of ground.

(4) casing 16x1/4, 63  
(material) (depth)

(size) if telescope see back.

(5) screen 4x1/4, 63  
(length) (depth to top)

16", DONNK  
(size) (material)

(6) pump 60 3000  
(HP) (yield gpm)

Diesel  
(type power)

(7) electric log No  
(yes or no)

(organization running log)


(8) how well bottom plugged steel plate

APR - 9 1971  
MISS. Bd. OF WATER COMMISSIONERS

DRILLERS REMARKS:  
None

If well telescopes please sketch and show depths.

GROUND LEVEL

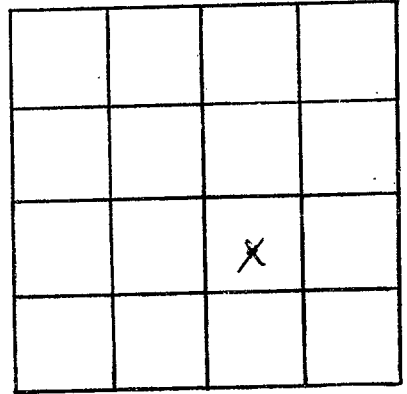

SECTION 12

Please indicate well location X.

ADDITIONAL INFORMATION

If more than one screen, show locations of each on sketch.