

TUNICA  
B39  
7-12-74

MISSISSIPPI  
BOARD OF WATER COMMISSIONERS  
416 North State Street  
Jackson, Mississippi 39201

CODED

WATER WELL DRILLERS LOG

JULY 12 1974 WATSON Co. TUNICA  
date well completed firm name county well located

LANDOWNER: IRWIN Co.  
ROBINSONVILLE, MISS.  
(mailing address)

description of formations encountered	from	to
GUMBO	0	15
SANDY CLAY	15	17
BLUE CLAY	17	31
MED. SAND	31	60
COARSE SAND	60	75

WELL LOCATION:  
sec. 13 T. 3 N. R. 10 E.  
6 miles W of ROBINSONVILLE  
(distance) (direction) (nearest town)

WELL PURPOSE: FARM  
(home, irrigation, municipal, industrial)

- WELL COMPLETION DATA:
- (1) diameter (inches) 2"
  - (2) total depth (feet) 75'
  - (3) static water level (feet) 17' <sup>(below)</sup>/<sub>(above)</sub> top of ground
  - (4) casing TOP 21' GAL STEEL  
PVC 65'  
(material) (depth)  
2" if telescope see back.  
(size)
  - (5) screen 10' 65'  
(length) (depth to top)  
2" PVC  
(size) (material)
  - (6) pump 2 50GPM  
(HP) (yield gpm)  
GASOLINE  
(type power)
  - (7) electric log No  
(yes or no)
  - (organization running log)
  - (8) how well bottom plugged PVC  
PLUG

DRILLERS REMARKS:


CODED

REGISTERED  
AUG 15 1974

MISS. BD. OF WATER COMMISSIONERS

If well telescopes please sketch and show depths.

GROUND LEVEL

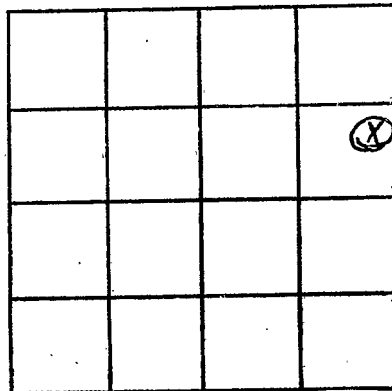

SECTION 13

Please indicate well location X.

ADDITIONAL INFORMATION

If more than one screen, show locations of each on sketch.