

TUNICA
B40
7-14-74

MISSISSIPPI
BOARD OF WATER COMMISSIONERS
416 North State Street
Jackson, Mississippi 39201

CODED

WATER WELL DRILLERS LOG

JULY 14 1974 WATSON Co. TUNICA
date well completed firm name county well located

LANDOWNER: IRWIN Co.
ROBINSONVILLE, MISS.
(mailing address)

description of formations encountered	from	to
GUMBO	0	42
FINE SAND	42	51
MED. SAND	51	63
COARSE SAND	63	75

WELL LOCATION:
sec. 17 T-3 N R-10 E
2 miles E. ROBINSONVILLE
(distance) (direction) (nearest town)

WELL PURPOSE: FARM
(home, irrigation, municipal, industrial)

- WELL COMPLETION DATA:
- (1) diameter (inches) 2"
 - (2) total depth (feet) 75
 - (3) static water level (feet) 12.5' below top of ground. TOP 21' OF GAL. STEEL
 - (4) casing PVC, 6.5' (material) (depth)
 - (size) if telescope see back.
 - (5) screen 10' length, 6.5' depth to top
2" PVC (size) (material)
 - (6) pump 2 HP, 55 (yield gpm)
GASOLINE (type power)
 - (7) electric log No (yes or no)
 - (organization running log)
 - (8) how well bottom plugged P.V.C. PLUG

DRILLERS REMARKS:


CODED

RECEIVED
AUG 15 1974

MISS. RD. OF WATER COMM.

If well telescopes please sketch and show depths.

GROUND LEVEL

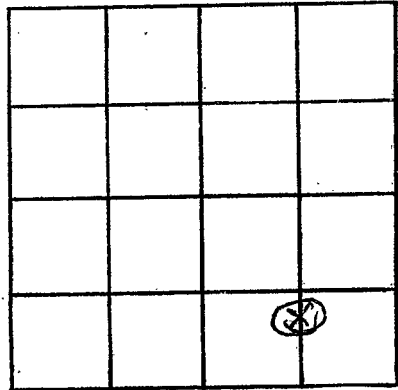

SECTION 17

Please indicate well location X.

ADDITIONAL INFORMATION

If more than one screen, show locations of each on sketch.