

TUNICA
 B41
 9-25-74

MISSISSIPPI
 BOARD OF WATER COMMISSIONERS
 416 North State Street
 Jackson, Mississippi 39201

CODED

WATER WELL DRILLERS LOG

9-25 1974 Hester Drilling Co. Tunica
 date well completed firm name county well located

LANDOWNER: Battle Spring Robbinsville Miss
 description of formations encountered from to
Clay 0 80
COARSE SAND 40 103
 (mailing address)

WELL LOCATION:
 sec. 21 T. 3 S. R. 4 E. W. 10
5 miles 12 of Robbinsville Miss
 (distance) (direction) (nearest town)

WELL PURPOSE:
 (home, irrigation, municipal, industrial)

WELL COMPLETION DATA:
 (1) diameter (inches) 16"
 (2) total depth (feet) 103'
 (3) static water level (feet) 11 below above top of ground.
 (4) casing steel, 63',
 (material) (depth)
16" If telescope see back.
 (size)
 (5) screen 40', 63'
 (length) (depth to top)
16, steel
 (size) (material)
 (6) pump 1.0 3000
 (HP) (yield gpm)
Diesel
 (type power)
 (7) electric log NO
 (yes or no)
 (organization running log)


RECEIVED
 OCT 29 1974

MISS. BD. OF WATER COMM

(8) how well bottom plugged _____
 DRILLERS REMARKS:

If well telescopes please sketch and show depths.

GROUND LEVEL

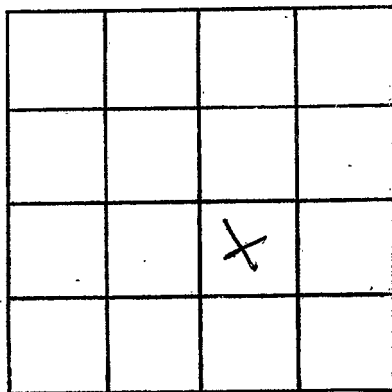

SECTION _____

Please indicate well location X.

ADDITIONAL INFORMATION

If more than one screen,
show locations of each on sketch.