

TUNICA  
B44  
3-30-76

MISSISSIPPI  
BOARD OF WATER COMMISSIONERS  
416 North State Street  
Jackson, Mississippi 39201

CODED

WATER WELL DRILLERS LOG

3-30-76  
date well completed

Hester Drilling Co  
firm name

Tunica  
county well located

LANDOWNER: Sam Phr Bus

description of formations encountered

from

to

Robin Sonville Miss

Clay	0	40
fine sand	40	52
GRAVEL & SAND	52	97

(mailing address)

WELL LOCATION:

low  
sec. 2 T 3 N R 4 E  
2 miles N of Banks  
(distance) (direction) (nearest town)

WELL PURPOSE: Irrigation  
(home, irrigation, municipal, industrial)

WELL COMPLETION DATA:

- (1) diameter (inches) 10"
- (2) total depth (feet) 97
- (3) static water level (feet) 6 below top of ground.
- (4) casing steel 57 (material) (depth)  
10" if telescope see back. (size)
- (5) screen 40, 57 (length) (depth to top)  
10, steel (size) (material)
- (6) pump 25, 1300 (HP) (yield gpm)  
Electric (type power)
- (7) electric log No (yes or no)

CODED

(organization running log)

(8) how well bottom plugged Plate


DRILLERS REMARKS:

MAY - 3 1976

MISS. BD. OF WATER COMMISSIONERS

If well telescopes please sketch and show depths.

GROUND LEVEL

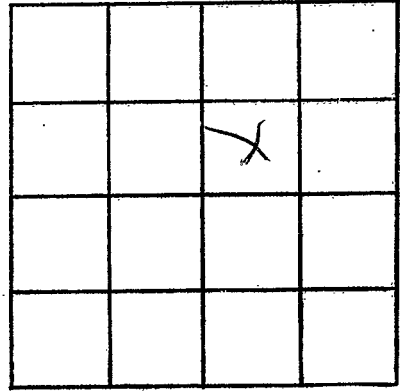

SECTION \_\_\_\_\_

Please indicate well location X.

ADDITIONAL INFORMATION

If more than one screen,  
show locations of each on sketch.