

TONICA  
B 45  
5-2-80

MISSISSIPPI  
 BOARD OF WATER COMMISSIONERS  
 416 North State Street  
 Jackson, Mississippi 39201

CODED

WATER WELL DRILLERS LOG

5-2 1980 Hester Drilling Co Tunica  
 date well completed firm name county well located

LANDOWNER: <u>G P OWEN</u> <u>Tunica MS</u>	description of formations encountered	from	to
(mailing address)	<u>CLAY</u>	<u>0</u>	<u>60</u>
WELL LOCATION: sec. <u>24</u> T. <u>3</u> N. R. <u>10</u> E	<u>fine sand</u>	<u>60</u>	<u>72</u>
miles _____ of _____ (distance) (direction) (nearest town)	<u>coarse sand &amp; gravel</u>	<u>72</u>	<u>117</u>
WELL PURPOSE: <u>irrigation</u> (home, irrigation, municipal, industrial)	CODED		
WELL COMPLETION DATA:			
(1) diameter (inches) <u>1 1/2</u>			
(2) total depth (feet) <u>117</u>			
(3) static water level (feet) <u>10</u> below/above top of ground			
(4) casing <u>steel</u> <u>77</u> (material) (depth)			
<u>1 1/2</u> if telescope see back. (size)			
(5) screen <u>40</u> <u>77</u> (length) (depth to top)			
<u>1 1/2</u> <u>steel</u> (size) (material)			
(6) pump <u>600</u> <u>3000</u> (HP) (yield gpm)			
<u>Direct</u> (type power)			
(7) electric log <u>no</u> (yes or no)			
(organization running log)			
(8) how well bottom plugged <u>Plastic</u>			
DRILLERS REMARKS:			

DEPT. OF NATURAL RESOURCES  
 BUREAU OF LAND & WATER RESOURCES


MAY 28 1980

RECEIVED

If well telescopes please sketch and show depths.

8

GROUND LEVEL

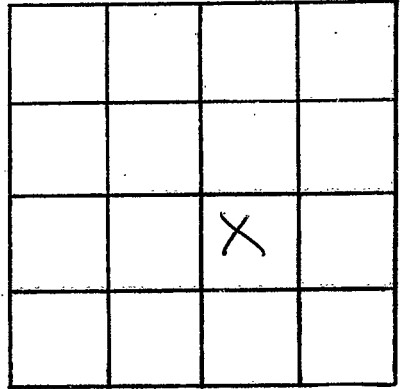

SECTION 24

Please indicate well location X.

ADDITIONAL INFORMATION

If more than one screen,  
show locations of each on sketch.