

TUNICA  
B 46  
5-12-80

MISSISSIPPI  
 BOARD OF WATER COMMISSIONERS  
 416 North State Street  
 Jackson, Mississippi 39201

CODED

WATER WELL DRILLERS LOG

5-12-80 19 Hester Drilling Co Tunica  
 date well completed firm name county well located

LANDOWNER: John B. Matthews  
Robbins, No. 113 MS  
 (mailing address)

description of formations encountered	from	to
<u>clay</u>	<u>0</u>	<u>23</u>
<u>fine sand</u>	<u>23</u>	<u>55</u>
<u>hard gravel</u>	<u>55</u>	<u>105</u>

WELL LOCATION:  
 sec. 33 T. 3 N. R. 10 E  
 (distance) miles (direction) of (nearest town)

WELL PURPOSE:  
 (home, irrigation, municipal, industrial)

CODED

WELL COMPLETION DATA:  
 (1) diameter (inches) 16"  
 (2) total depth (feet) 105'  
 (3) static water level (feet) 15 below above top of ground.  
 (4) casing steel 65' (material) (depth)  
16" if telescope see back. (size)  
 (5) screen 40 65' (length) (depth to top)  
16 steel (size) (material)  
 (6) pump 50 3000 (HP) (yield gpm)  
Diesel (type power)  
 (7) electric log NO (yes or no)  
 (organization running log)  
 (8) how well bottom plugged Plastic

DEPT. OF NATURAL RESOURCES  
 BUREAU OF LAND & WATER RESOURCES


MAY 28 1980

RECEIVED

DRILLERS REMARKS:

If well telescopes please sketch and show depths.

GROUND LEVEL

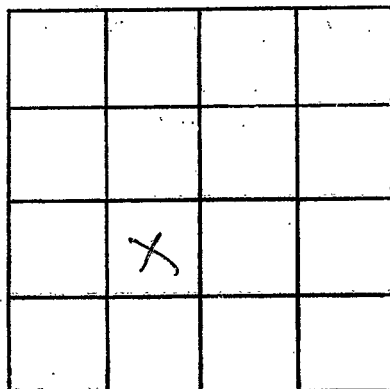

SECTION \_\_\_\_\_

Please indicate well location X.

ADDITIONAL INFORMATION

If more than one screen, show locations of each on sketch.