

TUNICA
B 47
5-8-80

MISSISSIPPI
BOARD OF WATER COMMISSIONERS
416 North State Street
Jackson, Mississippi 39201

WATER WELL DRILLERS LOG

CODED

5-8-80
date well completed

Hester Drilling Co
firm name

Tunica
county well located

LANDOWNER: Charles Berry
R. B. Binsonville MS
(mailing address)

description of formations encountered	from	to
clay	0	15
fine sand	15	55
sand + gravel	55	103

WELL LOCATION:
sec. 27 T 3 N 8 R 10 E
(distance) (direction) (nearest town)

WELL PURPOSE: irrigation
(home, irrigation, municipal, industrial)

- WELL COMPLETION DATA:
- (1) diameter (inches) 16"
 - (2) total depth (feet) 103
 - (3) static water level (feet) 7 below top of ground
 - (4) casing steel 103
(material) (depth)
16" if telescope see back.
(size)
 - (5) screen 40 63
(length) (depth to top)
16" steel
(size) (material)
 - (6) pump 60 3000
(HP) (yield gpm)
Direct
(type power)
 - (7) electric log no
(yes or no)

(organization running log)
 - (8) how well bottom plugged Plastic

CODED


DEPT. OF NATURAL RESOURCES
BUREAU OF LAND & WATER RESOURCES

MAY 28 1980
RECEIVED

DRILLERS REMARKS:

If well telescopes please sketch and show depths.

GROUND LEVEL

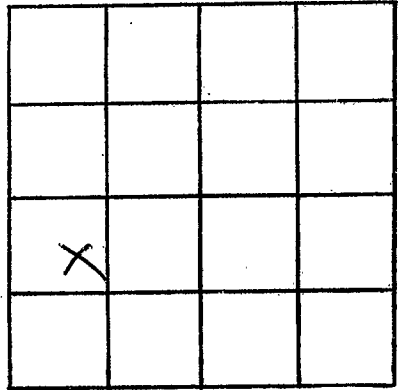

SECTION _____

Please indicate well location X.

ADDITIONAL INFORMATION

If more than one screen,
show locations of each on sketch.