

B 54

BOARD OF WATER COMMISSIONERS  
416 North State Street  
Jackson, Mississippi 39201

CODED

WATER WELL DRILLERS LOG

9/10/86  
date well completed

19 Five Co Form  
firm name

Lunice  
county well located

LANDOWNER:  
Charles Berry  
Lunice  
(mailing address)

description of formations encountered	from	to
<u>Top clay</u>	<u>0</u>	<u>14</u>
<u>Fine sand</u>	<u>14</u>	<u>28</u>
<u>Med sand</u>	<u>28</u>	<u>46</u>
<u>Coarse sand</u>	<u>46</u>	<u>68</u>
<u>Sand &amp; Gr</u>	<u>68</u>	<u>106</u>

WELL LOCATION:  
sec 33 T 3 N R 10 E  
S W  
5 miles S-E of Bellevue  
(distance) (direction) (nearest town)

WELL PURPOSE:  
(home, irrigation, municipal, industrial)

- WELL COMPLETION DATA:
- (1) diameter (inches) 16"
  - (2) total depth (feet) 106'
  - (3) static water level (feet) 14 below above top of ground.
  - (4) casing Steel, 56  
(material) (depth)  
16"  
(size) if telescope see back.
  - (5) screen 50', 56  
(length) (depth to top)  
16", Steel  
(size) (material)
  - (6) pump 50 2600  
(HP) (yield gpm)  
Elec  
(type power)
  - (7) electric log no  
(yes or no)  
  
(organization running log)
  - (8) how well bottom plugged well


DRILLERS REMARKS:

CODED

RECEIVED  
SEP 23 1986

Department of Natural Resources  
Bureau of Land & Water Resources

GROUND LEVEL

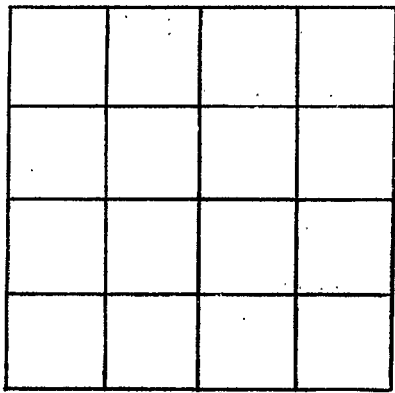

SECTION \_\_\_\_\_

Please indicate well location X.

ADDITIONAL INFORMATION

A series of horizontal lines providing space for additional information or notes.

If more than one screen, show locations of each on sketch.