County: <u>The County</u> Permit #: <u>Office of La</u> Driller: <u>Office of La</u> Date drilling completed: <u>S-24,0</u> 6 (f		For Office Use Only: Aquifer:
Owner Name_T, E, Srubbl		Ur Longitude: <u>Mo. 13</u> , 20
Mailing Address: 2820 Bonks Rd	Method of Lat/Long (circle of	0 12
		I GPS, Survey-grade GPS
Lobin Da Ville 945 386 City State Zip Code Telephone No. (92) 497-7792	SE NE 14	Twn 35 Rng 10W Nearest Town of Kebinero Ma 0 304
٧	Vell Data	1.0 M
urpose of Well (circle one) Home Industrial Public Supply Irrigation Fish Culture Other: Rollace Bod Well		
Date well drilling started: $5 - 24$	Date well drilling completed:	5-24-
If flowing, method of flow regulation: Valve Oth		
Static Water Level: feet above or below (circle of	one) land surface Date measured;	5-26-06
Method of Measurement (circle one) steel tape electric	-	
Hole depth: 10 Well depth: 10	Well grouted to a depth of	feet
	Mix	PIC
Casing length: <u>55</u> feet Casing diameter: <u>1</u> k		
	inches Type of screen:	
Screen slot size: 103 inches Setting depth: Fr	rom 55 feet to 5	<u>feet</u>
Type of completion (circle all applicable): Gravel packed	Underreamed Telescoped Oper	n hole Natural Development
Other (describe):		
Top of lap pipe or reduction in casing:feet.	If telescoped or more than one sc	reen, describe on back of page
Logs run (circle all applicable): No log run Electric Gamma	a Ray Density Sonic Neutron	Other: 1/5 AVL
Name of organization running log(s): I certify that the well was drilled, constructed, and complete	d in accordance with all applicable	e requirements of the Mississippi
Department of Environmental Quality and/or the Mississipp <u>ALAW PYLE</u> <u>0674</u> Print Name of Water Well Contractor and License No.	Blar	of Water Well Contractor
realonement	for 61002545	DEAC
reprucement		RECEI
	· · · · · · · · · · · · · · · · · · ·	JUN 02

BY: OLWR


If well telescopes please sketch below and show depths.

Ground Level

Description of Formations Encountered	From	To
Autor + "	0	4
Sal	12	5
Carros	-22	90
Courses send	- OC	1
pa Carbo	40	14
		-
		-
· · · · · · · · · · · · · · · · · · ·		
······································		1
		-
		+
		1
		1
		1-
69		

67

If more than one screen, show location of each on sketch

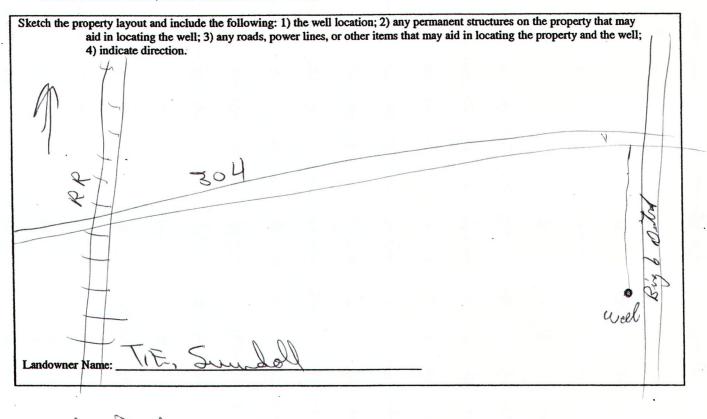

Signature of Water Well Contractor

JUN 0 2 2006 BY: OLWR

STATE W	ELL REPORT	
County: Pump Installer Permit #: Office of Land	Part 2 S Completion Report nt of Environmental Quality and Water Resources Box 10631 For Office Use Only: Aquifer:	
Date completed:	Well #:	
This report should be prepared by the pump installer in deta installation of pump.	il and filed with the Department within 30 days of the	
Well Owner Information	Well Location	
Owner Name: TE Sunfell	Latitude: 54 49480 Longitude: 69 3-21	
Mailing Address:	Method of Lat/Long (circle one): Conventional Survey,	
Same and Part	USGS quad, Hand-held GPS, Survey-grade GPS	
City State Zip Code	<u>A/E 14 5E 14 Sec 14</u> Twn 5 Rng 10 W	
Telephone No. ()	Distance Direction Nearest Town <u>S</u> Miles <u>E</u> of <u>Robinson II a</u> m	
ton Hars Purp Pump Type to move Circle one	Power Type Circle one	
Air Lift Jet Submersible	Diesel Engine Gasoline Engine Natural Gas	
Bucket Piston Turbine Centrifugal Rotary Flowing Well	Electric Motor Hand Tractor PTO	
Other (specify):	Windmill Other (specify): Horse Power Rating of Motor: Go H, f,	
Date Pump Installed: Pring to Be Set I outer	Setting Depth: 50 feet	
Rated Pump Capacity: 3000 Gallons Per Minute	Number of Stages:	
Pump Test Data	Method of Measuring Water Level	
Date Well Tested:	Circle one	
Static Water Level (A):Feet Below Land Surface	Air Line Electric Measuring Line Steel-Tape	
Pumping Water Level (B):Feet Below Land Surface	Other (specify):	
Drawdown [(B) – (A)]:Feet Below Land Surface	For flowing well, measured shut in head:feet	
Test Pumping Rate:Gallons Per Minute	Well yielded GPM with a drawdown of	
Duration of Pump Test (minimum 4 hours):hours	feet afterhours of pumping	
I HEREBY CERTIFY that the above statements are true to the best of	of my knowledge. Signature of Pump Installer	
	or produce of a spin produce	

JUN 0 2 2006 BY: OLWR