

State Well Report

Part 1 – Driller's Log

Mississippi Department of Environmental Quality
Office of Land and Water Resources
P.O. Box 2309
Jackson, MS 39225
(601)961- 5210
(601)961- 5228 (fax)

County: Tunica
Permit #: GW43501
Driller: Delta Drilling of Tunica Inc.
Date drilling completed: 8-28-09

For Office Use Only:

Aquifer: _____
Well #: B75
L. S. Elevation: _____
E-log #: _____

State Law requires that this report be prepared by the license holder responsible for the work and filed with the Department at the above address within 30 days of completion of drilling of the well or borehole.

Information on Well Owner <i>(Landowner if borehole is not for a water well)</i>	Well or Borehole Location
Owner Name: <u>Buddy Allen</u>	Latitude: <u>34° 46' 62"</u> Longitude: <u>90° 12' 57.3"</u>
Mailing Address: <u>A. J. Planting</u>	Method of Lat/Long (circle one): Conventional Survey, <u>38</u>
<u>P.O. Box 2309</u>	USGS quad: <u>Hand-held GPS</u> Survey-grade GPS
<u>Tunica, MS. 38676</u>	<u>NE 1/4 SE 1/4 Sec 36</u> ✓ <u>Twon 35</u> ✓ <u>Rng 10W</u> ✓
City: _____ State: _____ Zip Code: _____	Distance: <u>6</u> Miles Direction: <u>ESE</u> of Nearest Town: <u>Robinsonville, MS</u>
Telephone No. <u>(662) 357-5400</u>	

Well / Borehole Data

Date drilling started: 8-28-09 Date drilling completed: 8-28-09 Hole depth: 100' Hole diameter: 28"

Location of the source of any surface water used for drilling: Water Well 1/4 mile east of well drilled

Method of dosing and volume of Chlorine used in drilling and development: _____

Logs run (circle all applicable): No log run Electric Gamma Ray Density Sonic Neutron Other: _____

Name of organization running log(s): _____

Purpose of borehole (check one): Water Well Geotechnical/Geological Investigation _____ Ground Source Heat Pump _____

Seismic Survey _____ Other (describe) _____

If drilling is not related to water well construction, skip the remainder of this block

Purpose of Well (check one): Home _____ Industrial _____ Public Supply _____ Irrigation Fish Culture _____ Other: _____

If a flowing well, method of flow regulation: Valve _____ Other (describe) _____

Static Water Level: 24 feet above or below (circle one) land surface Date measured: 8-1-09

Method of Measurement (circle one) steel tape electric tape air line other: _____

Well depth: 100' Well grouted to a depth of 10 feet Type of grout (circle one): Neat Cement Bentonite Mix

Casing length: 60 feet Casing diameter: 16" inches Type of casing: PVC

Screen length: 40 feet Screen diameter: 16" inches Type of screen: PVC

Screen slot size: .032 inches Setting depth: From 100 feet to 100 feet

Type of completion (circle all applicable): Gravel packed Underreamed Telescoped Open hole Natural Development

Other (describe): _____

Top of lap pipe or reduction in casing: _____ feet. *If telescoped or more than one screen, describe on next page*

Form: OLWR-SWR-1A (04/08)


RECEIVED

SEP 16 2009

BY: OLWR

The sketch below only required for water wells


If well telescopes, show depths on sketch.

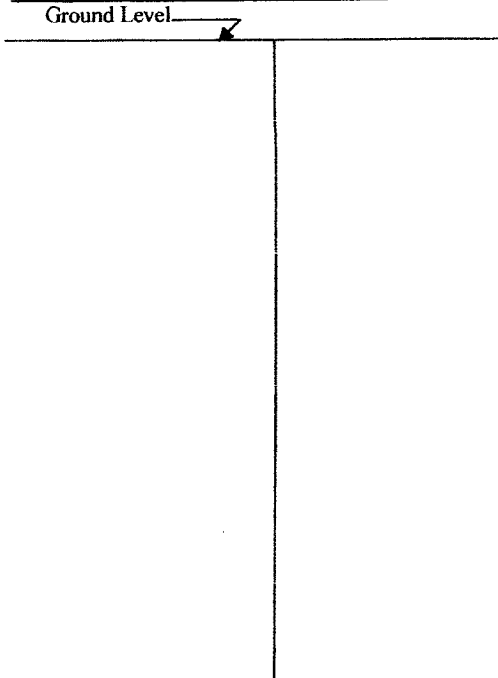

Description of formations encountered must be provided for all wells and boreholes, unless specifically exempted by regulations

Description of Formations Encountered	From (depth)	To (depth)
heavy clay	Ground Level	44
coarse sand and gravel formation	75	100

If more than one screen, show location of each on sketch

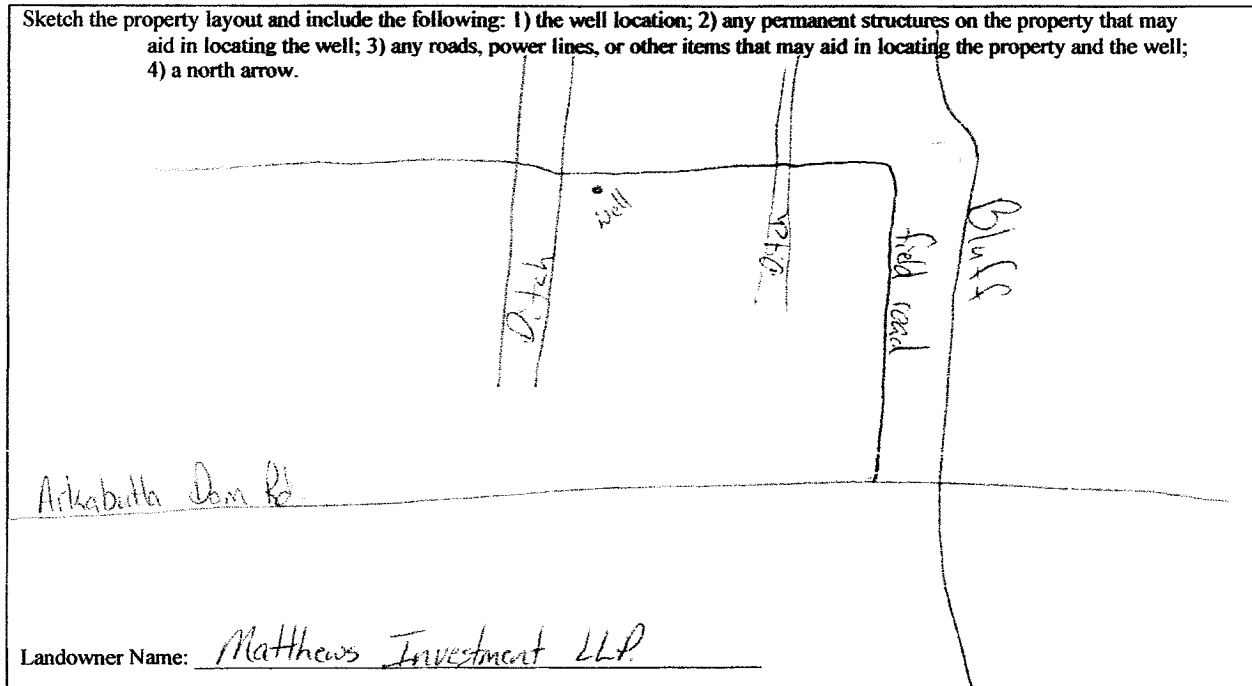

Form: OLWR-SWR-1A (04/08)

I certify that the well/borehole was drilled, constructed, and completed in accordance with all applicable requirements of the Mississippi Department of Environmental Quality and the Mississippi Department of Health regulations, if applicable, and state laws.

Alan Pyle #0674 9-14-09 Alan Pyle

Print Name of Responsible Licensee and License No. Date Signature of Licensee

RECEIVED
SEP 16 2009
BY: OLWR

STATE WELL REPORT

Part 2

Pump Installer's Completion Report
 Mississippi Department of Environmental Quality
 Office of Land and Water Resources
 P.O. Box 2309
 Jackson, MS 39225
 (601)961-5210
 (601)961-5228 (fax)

For Office Use Only:

Aquifer: _____
 Well #: B75
 Elevation: _____

County: Tunica

Permit #: _____

Driller: Delta Drilling of Tunica Inc.

Date completed: 9-1-09

Copy information from block on Part 1

This part of the report must be completed by a licensed water well contractor or a licensed pump installer. A copy of Part 1 of the report must be attached and both parts filed with the Department at the above address within 30 days of well completion.

Well Owner Information	Well Location
Owner Name: <u>Buddy Allen</u>	Latitude: <u>34° 46.626'</u> Longitude: <u>90° 12.573'</u>
Mailing Address: <u>A²J Planting</u>	Method of Lat/Long (check one): Conventional Survey _____
<u>P.O. Box 2309</u>	USGS quad _____, Hand-held GPS <input checked="" type="checkbox"/> , Survey-grade GPS _____
<u>Tunica, MS 38676</u>	<u>NE 1/4 SE 1/4 Sec 36 T 35 R 10W</u>
City State Zip Code	Distance Direction Nearest Town
Telephone No. <u>(662) 357-5400</u>	<u>6</u> Miles <u>ESE</u> of <u>Robinsonville, MS</u>

Pump Type Circle one	Power Type Circle one
Air Lift <input type="checkbox"/> Jet <input type="checkbox"/> Submersible <input type="checkbox"/>	<u>Diesel Engine</u> Gasoline Engine Natural Gas
Bucket <input type="checkbox"/> Piston <input type="checkbox"/> <u>Turbine</u>	Electric Motor Hand Tractor PTO
Centrifugal <input type="checkbox"/> Rotary <input type="checkbox"/> Flowing Well <input type="checkbox"/>	Windmill Other (specify): _____
Other (specify): _____	Horse Power Rating of Motor: <u>100</u>
Date Pump Installed: <u>9-1-09</u>	Setting Depth: <u>60</u> feet
Rated Pump Capacity: <u>2600</u> Gallons Per Minute	Number of Stages: <u>2</u>

Pump Test Data	Method of Measuring Water Level Circle one
Date Well Tested: _____	Air Line Electric Measuring Line <u>Steel Tape</u>
Static Water Level (A): _____ Feet Below Land Surface	Other (specify): _____
Pumping Water Level (B): _____ Feet Below Land Surface	For flowing well, measured shut in head: _____ feet
Drawdown [(B) - (A)]: _____ Feet Below Land Surface	Well yielded _____ GPM with a drawdown of _____ feet after _____ hours of pumping
Test Pumping Rate: _____ Gallons Per Minute	
Duration of Pump Test (minimum 4 hours): _____ hours	

This is for (circle one): New Well Replacement of Existing Pump Repair of Existing Pump

I HEREBY CERTIFY that the above statements are true to the best of my knowledge.

Alan Pyle #0674 Alan Pyle
 Print Name of Pump Installer and License No. (if applicable) Signature of Pump Installer

Form: OLWR-SWR-1C (07-09)

RECEIVED
 SEP 16 2009
 BY: OLWR