

TUNICA
B 2000
12-4-75

MISSISSIPPI
BOARD OF WATER COMMISSIONERS
416 North State Street
Jackson, Mississippi 39201

WATER WELL DRILLERS LOG

Tunica

12-4-75

Bob Smith Well Dr.

~~DeWitt~~

date well completed

firm name

county well located

LANDOWNER:

Wm. Bowers, Jr.

Arkansas, Mo.
(mailing address)

WELL LOCATION:

sec. 30 T 3 N R 10 E
11 miles SW of Cudora
(distance) (direction) (nearest town)

WELL PURPOSE:

None
(home, irrigation, municipal, industrial)

WELL COMPLETION DATA:

- (1) diameter (inches) 4
(2) total depth (feet) 165
(3) static water level (feet) 100 below top of ground.
(4) casing Plastic 165
(material) (depth)

(size) If telescope see back.

- (5) screen 20 145
(length) (depth to top)

4 Plastic
(size) (material)

- (6) pump 1/3 10
(HP) (yield gpm)

Elec
(type power)

- (7) electric log no
(yes or no)

(organization running log)

- (8) how well bottom plugged plugged

description of formations encountered

from

to

top soil	0	5
red clay	5	35
gravel	35	60
blue clay	60	100
sand	100	165

RECEIVED
FEB 23 1976


FEB 23 1976

DRILLERS REMARKS:

MISS. BD. OF WATER COMM

If well telescopes please sketch and show depths.

GROUND LEVEL

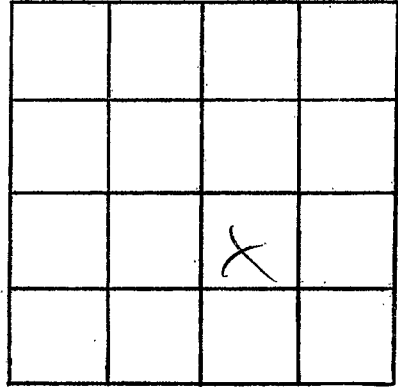

SECTION _____

Please indicate well location X.

ADDITIONAL INFORMATION

If more than one screen,
show locations of each on sketch.