

Junica
C3
9-67

MISSISSIPPI
BOARD OF WATER COMMISSIONERS
416 North State Street
Jackson, Mississippi 39201

CODED

WATER WELL DRILLERS LOG

Sept 12 1967 Shelby Reynor Junica
date well completed firm name county well located

LANDOWNER: W. B. Webb
Junica Miss

(mailing address)

WELL LOCATION:

sec 22 T 4 N 52 R 12 W
0 miles W of Junica
(distance) (direction) (nearest town)

WELL PURPOSE: Cattle
(home, irrigation, municipal, industrial)

WELL COMPLETION DATA:

- (1) diameter (inches) 2
- (2) total depth (feet) 92
- (3) static water level (feet) 20 below top of ground.
- (4) casing Galvange (material) (depth)

 if telescope see back.
(size)

- (5) screen 6ft (length) (depth to top)
90 (size) gal (material)


- (6) pump 1/2 (HP) 8 (yield gpm)
Electric (type power)

- (7) electric log No (yes or no)
No (organization running log)

- (8) how well bottom plugged Bubbly Seal

description of formations encountered	from	to
<u>Black Clay</u>	<u>0</u>	<u>10</u>
<u>Sandy</u>	<u>10</u>	<u>90</u>
<u>Grey Sand</u>	<u>90</u>	<u>92</u>

CODED

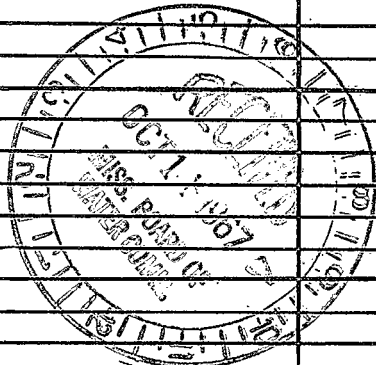

DRILLERS REMARKS:

If well telescopes please sketch and show depths.

GROUND LEVEL

Well ←

	SE ⁴ SW ⁴		
	SE ⁴ SW ⁴		

SECTION 22

Please indicate well location X.

ADDITIONAL INFORMATION

If more than one screen,
show locations of each on sketch.