

Tunica  
CA  
9-66

MISSISSIPPI BOARD OF WATER COMMISSIONERS

WATER WELL DRILLERS LOG

**CODED**

Date: Sept 21 1966, Driller: Shelby Neyman County Tunica  
(Name)

(1) Owner of Land:	Description & Color of Materials Sand, Clay, Red Clay, Shell, etc.	Thick- ness Feet	Depth Feet
<u>Mr. Susie W. Queen</u> (Name) <u>Tunica Miss.</u> (Address)	<u>Black Clay</u>	<u>8</u>	<u>8</u>
(2) Location: <u>SW 1/4 SW 1/4, Sec 27 T14R12</u> <u>6</u> miles <u>West</u> , of <u>Tunica Miss.</u> (distance) (direction) (Nearest Town)	<u>Blue Sand</u>	<u>67</u>	<u>75</u>
(3) Topography: <u>Flat</u> (Hilly) (Flat) (Level)			
(4) Purpose of Well: <u>Domestic</u> (Domestic Irrigation Municipal, Industrial, Other)			

Information upon completion of well:

(1) Diameter 2 inches.

(2) Total Depth 75 feet.

(3) Water Level 28 feet below top of ground.

(4) Cased to 69 ft, Size 2

(5) Screen: Size 6, Length 5 ft

(6) Were any formations sealed against pollution?


**CODED**

yes yes, \_\_\_\_\_ no.

If YES depth of formation within 12 ft of top of surface

Why Sand fell into sealed pipe

Drillers Remarks:

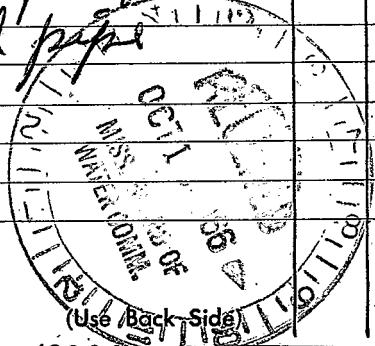

Well No.

