

TUNICA
C 7
7-30-81

COEDED

Jackson, Mississippi 39201
WATER WELL DRILLERS LOG

7-30-81 date well completed
Hester Drilling Junior firm name
county well located

LANDOWNER: W. H. Howard
Farm
Tunica, Miss
(mailing address)

description of formations encountered	from	to
Clay	0	42
fine sand	42	58
Coarse sand + gravel	58	103

WELL LOCATION:
sec. 17 T. 6 S. R. 12 W.
3 miles west of Tunica
(distance) (direction) (nearest town)

WELL PURPOSE: golf
(home, irrigation, municipal, industrial)

- WELL COMPLETION DATA:
- (1) diameter (inches) 8"
 - (2) total depth (feet) 103
 - (3) static water level (feet) 12 below above top of ground.
 - (4) casing plastic, 63
(material) (depth)
 - (size) If telescope see back.
 - (5) screen 40, 63
(length) (depth to top)
 - 8, plastic
(size) (material)
 - (6) pump 15, 1100
(HP) (yield gpm)
 - Elect
(type power)
 - (7) electric log no
(yes or no)

(organization running log)
(8) how well bottom plugged plastic

DRILLERS REMARKS:


DEPT. OF NATURAL RESOURCES
BUREAU OF LAND & WATER RESOURCES

SEP - 9 1981

RECEIVED

If well telescopes please sketch and show depths.


GROUND LEVEL

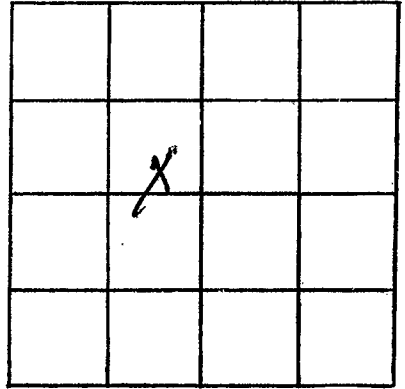

SECTION 12

Please indicate well location X.

ADDITIONAL INFORMATION

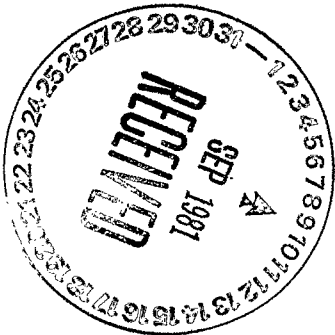

If more than one screen, show locations of each on sketch.