

Tunica
 C 11
 6-2-70
 3

MISSISSIPPI
 BOARD OF WATER COMMISSIONERS
 416 North State Street
 Jackson, Mississippi 39201

CODED

WATER WELL DRILLERS LOG

6/2-1970 date well completed
 J.H. ABELSON firm name
 Tunica county well located

LANDOWNER: MR. W.B. WEBB JR.
 Tunica MISS (mailing address)
 sec 27 T. 4 R. 12 186
 5 1/2 miles NNE of Tunica
 (distance) (direction) (nearest town)

description of formations encountered	from	to
Clay	1	15
heavy sand	15	22
fine sand	22	30
med. sand	30	37
coarse med sand	37	50

WELL PURPOSE: WATER LIVE STOCK
 (home, irrigation, municipal, industrial)

WELL COMPLETION DATA:

- (1) diameter (inches) 1 1/2"
- (2) total depth (feet) 46'
- (3) static water level (feet) 16' below top of ground
- (4) casing 1/2" coil, 42' (material) (depth)
- if telescope see back. (size)
- (5) screen 4' (length), 42' (depth to top)
- 1/2" BRASS DRIVE POINT (size) (material)
- (6) pump 1/2 (HP), 10 (yield gpm)
- ELECTRIC (type power)
- (7) electric log NO (yes or no)
- (organization running log)
- (8) how well bottom plugged STEEL POINT

CODED


JUN 8 1970

MISC. DD. OF WATER COMM.

DRILLERS REMARKS: WELL USED TO WATER LIVESTOCK.

If well telescopes please sketch and show depths.

GROUND LEVEL

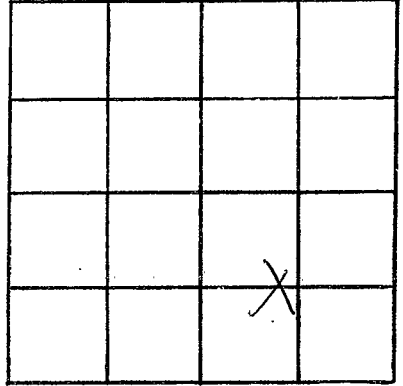

SECTION 27

Please indicate well location X.

ADDITIONAL INFORMATION

If more than one screen, show locations of each on sketch.