

MISSISSIPPI DEPARTMENT OF NATURAL RESOURCES

Bureau of Land and Water Resources

Southport Mall

P.O. Box 10631

Jackson, Mississippi 39209

WATER WELL DRILLERS LOG

LAYNE-CENTRAL

Tunica  
~~1418~~ C 13  
~~1418~~  
6W-14592

Gold

08/11

19 93

Hollywood Water Assn.

Tunica

date well completed

firm name

county well located

Tunica County Utility  
 LANDOWNERS Hollywood Water

DISTRICT

description of formations encountered

from

to

P. O. Box 643

Tunica, MS 38676

(mailing address)

See Attached for Log!

WELL LOCATION:

12

NE SE 1418  
 sec. 4 T 4 N R 11 E  
 West of Tunica  
 at Levee  
4 miles of  
 (distance) (direction) (nearest town)

WELL PURPOSE: Municipal  
 (home, irrigation, municipal, industrial)

WELL COMPLETION DATA:

- (1) diameter (inches) 16"
- (2) total depth (feet) 1869'
- (3) static water level (feet) 38' below top of ground.
- (4) casing Steel, 1735',  
 (material) (depth)

         if telescope see back.  
 (size)

- (5) screen 100', 1740'  
 (length) (depth to top)  
10", Stainlee Steel  
 (size) (material)

- (6) pump 100 1000  
 (HP) (yield gpm)  
3/460/60  
 (type power)

- (7) electric log Yes  
 (yes or no)  
Layne-Central  
 (organization running log)

- (8) how well bottom plugged Cement

RECEIVED


SEP 10 1993

Dept. of Environmental Quality  
 Office of Land & Water Resources

DRILLERS REMARKS:

If well telescopes please sketch and show depths.

GROUND LEVEL

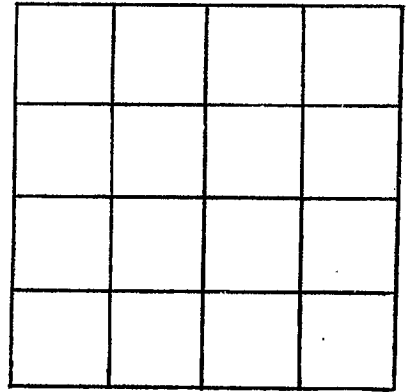

SECTION \_\_\_\_\_

Please indicate well location X.

ADDITIONAL INFORMATION

If more than one screen,  
show locations of each on sketch.