

Tunica
 C 2000
 9-18-80

MISSISSIPPI
 BOARD OF WATER COMMISSIONERS
 416 North State Street
 Jackson, Mississippi 39201

WATER WELL DRILLERS LOG

9-18-1980 date well completed
 Highs Well Co. firm name
 Tunica county well located


LANDOWNER: <u>Ray Sheffield</u>	description of formations encountered	from	to
<u>Tunica, Ms.</u> (mailing address)	<u>Black Clay</u>	0	15
WELL LOCATION: sec <u>34</u> T <u>4</u> N R <u>12</u> E <u>2</u> miles <u>W</u> of <u>Tunica</u> (distance) (direction) (nearest town)	<u>White Sand</u>	15	95
WELL PURPOSE: <u>Stair</u> (home, irrigation, municipal, industrial)			
WELL COMPLETION DATA: (1) diameter (inches) <u>4"</u> (2) total depth (feet) <u>95</u> (3) static water level (feet) <u>40</u> below top of ground. (4) casing <u>PVC</u> <u>95</u> (material) (depth) _____ if telescope see back. (size) (5) screen <u>2"</u> <u>28</u> (length) (depth to top) <u>4"</u> <u>gravel type</u> (size) (material) (6) pump <u>1/2</u> <u>10</u> (HP) (yield gpm) <u>220W</u> (type power) (7) electric log <u>No</u> (organization running log) (8) how well bottom plugged <u>Cap</u>			
DRILLERS REMARKS:			

DEPT. OF NATURAL RESOURCES
 BUREAU OF LAND & WATER RESOURCES

OCT 29 1980
 RECEIVED

If well telescopes please sketch and show depths.

GROUND LEVEL

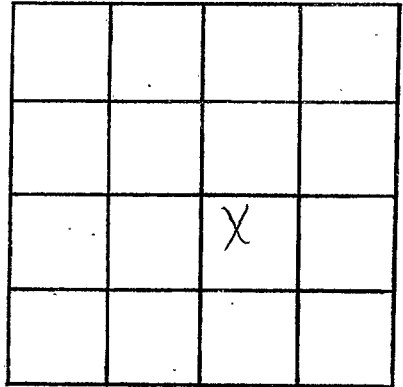

SECTION

34

Please indicate well location X.

ADDITIONAL INFORMATION

If more than one screen,
show locations of each on sketch.