

ELOG #6

TUNICA
D 6
11-68

MISSISSIPPI
BOARD OF WATER COMMISSIONERS
416 North State Street
Jackson, Mississippi 39201

CODED

CODED

WATER WELL DRILLERS LOG

U.S.G.S
1968
date well completed

Robert E. Kallhoff Co.
firm name

Tunica
county well located

LANDOWNER: Hollywood
Water Assn. Inc.
Hollywood, Miss.
(mailing address)

description of formations encountered	from	to
Top soil & Sand	0	34
Sand	34	62
Gravel	62	152
Gravel, Gumbo	152	181
Gumbo	181	242
Gumbo, Sand	242	273
Sand	273	334
Gumbo & Sand	334	365
Sand, Gumbo	365	397
Sand	397	425
Sand, Gumbo	425	457
Sand	457	548
Gumbo	548	609
Shale, Sand	609	639
Shale	639	671
Shale & Sand	671	884
Sand	884	916
Sand & Shale	916	1049
Sand	1049	1215
Sand & Shale (Chalk)	1215	1369
Sand & Gumbo	1369	1399
Sand, Rock	1399	1430
Sand, Shale	1430	1492
Shale, Sand	1492	1584
Sand, Rock, Shale	1584	1614
Sand	1614	1676
Sand, Shale	1676	1859
Sand	1859	1952

WELL LOCATION:
sec. 10 T 4 N R 11 E
in Hollywood
(distance) miles (direction) (nearest town)

WELL PURPOSE: Community
(home, irrigation, municipal, industrial)

WELL COMPLETION DATA:

(1) diameter (inches) 7 X 4

(2) total depth (feet) 1830

(3) static water level (feet) 6' below top of ground.

(4) casing Bl. St. 1740 (material) (depth)
17" (size) If telescope see back.


(5) screen 40 1760 (length) (depth to top)
4" (size) S.S. (material)

(6) pump 10 100 (HP) (yield gpm)
electric (type power)

(7) electric log Yes (yes or no)
U.S.G.S. (organization running log)


(8) how well bottom plugged B.P.V

DRILLERS REMARKS: 50 feet of 4" pipe between screen sections

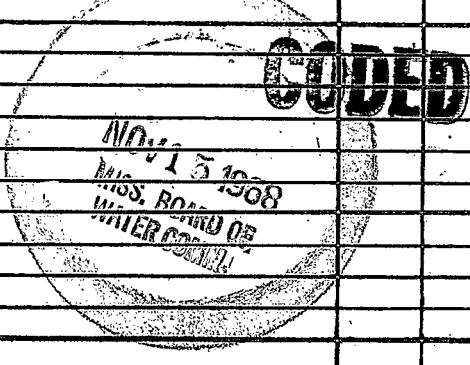

If well telescopes please sketch and show depths.

GROUND LEVEL

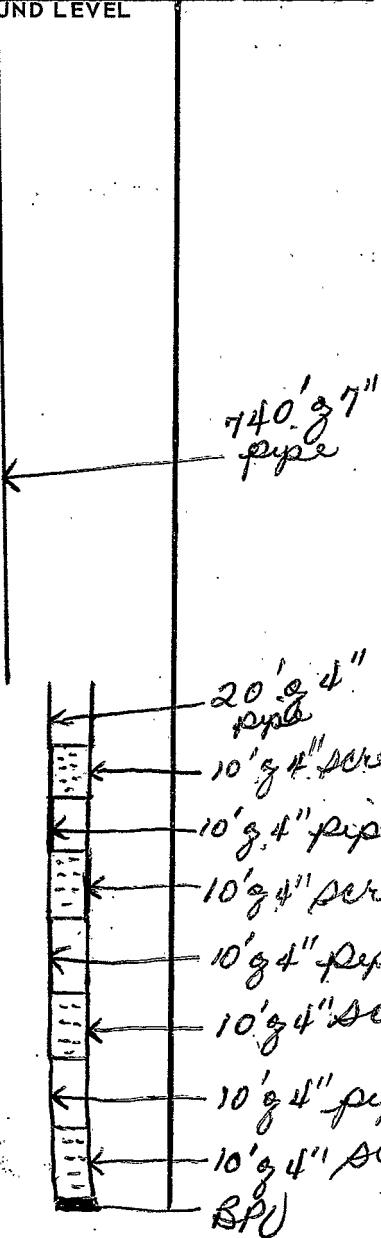

SECTION 10

Please indicate well location X.

ADDITIONAL INFORMATION

If more than one screen, show locations of each on sketch.