

CODED

MISSISSIPPI  
BOARD OF WATER COMMISSIONERS  
416 North State Street  
Jackson, Mississippi 39201

WATER WELL DRILLERS LOG

52 1974 Master Drilling Co Tunica  
date well completed firm name county well located

LANDOWNER: J & Seward  
Robbinsonville,  
Miss.  
(mailing address)


| description of formations encountered | from      | to         |
|---------------------------------------|-----------|------------|
| <u>clay</u>                           | <u>0</u>  | <u>20</u>  |
| <u>fine sand</u>                      | <u>20</u> | <u>40</u>  |
| <u>coarse sand</u>                    | <u>40</u> | <u>100</u> |

WELL LOCATION:  
sec. 10 T 4 N R. 11 E  
1 miles NW of Hollywood  
(distance) (direction) (nearest town)

WELL PURPOSE:  
(home, irrigation, municipal, industrial)

- WELL COMPLETION DATA:
- (1) diameter (inches) 16"
  - (2) total depth (feet) 100
  - (3) static water level (feet) 13 below above top of ground.
  - (4) casing steel, 100,  
(material) (depth)  
16" if telescope see back.  
(size)
  - (5) screen 40, 60  
(length) (depth to top)  
16", steel  
(size) (material)
  - (6) pump 60 3000  
(HP) (yield gpm)  
Direct  
(type power)
  - (7) electric log NO  
(yes or no)
  - (8) how well bottom plugged Plastic

CODED

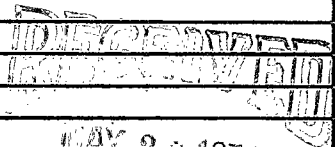


MAY 20 1974

DRILLERS REMARKS:

MISS. BD. OF WATER COMMISSIONERS

If well telescopes please sketch and show depths.

GROUND LEVEL

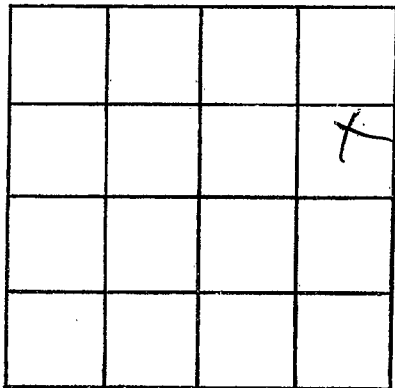

SECTION \_\_\_\_\_

Please indicate well location X.

ADDITIONAL INFORMATION

If more than one screen,  
show locations of each on sketch.