

WATER WELL DRILLERS LOG

CODED

Date: July 26, 1965, Driller: Layne-Central Co. County _____

(Name)

- (1) Owner of Land: Town of Tunica
(Name)
Tunica, Mississippi
(Address)
- (2) Location: SE 1/4, SE 1/4, Sec. 32 T. 9S R. 11W
(distance) (direction) (Nearest Town)
- (3) Topography: _____
(Hilly) (Flat) (Level)
- (4) Purpose of Well: Municipal
(Domestic Irrigation
Municipal, Industrial, Other)


Information upon completion of well:

- (1) Diameter 10 inches.
- (2) Total Depth 1805 feet.
- (3) Water Level 4' above ground / feet below top of ground.
- (4) Cased to 1710', Size 10"
- (5) Screen: Size 6", Length 80'
- (6) Were any formations sealed against pollution?
x yes, _____ no.

If YES depth of formation 1710'
Why _____ required

Drillers Remarks: _____

Description & Color of Materials Sand, Clay, Red Clay, Shell, etc.	Thick- ness Feet	Depth Feet
gumbo	45	45
coarse sand	59	104
coarse sand-gravel	53	157
clay	47	204
rock	1	205
clay	48	253
sandy shale	29	282
fine sand	55	337
shale	58	395
medium sand	95	490
shale	80	570
sand	32	602
sandy shale	55	657
shale	31	688
rock	1	689
shale	106	795
rock	1	796
shale	29	825
sand	26	851
sandy shale	39	940
sand	30	970
sandy shale	217	1187
hard shale	47	1234
rock	6	1240
hard shale	198	1438
sandy shale	138	1576
rock	3	1579
sandy shale	87	1660
fine brown sand	25	1685
medium sand	115	1800
shale	4	1804
	19	1823

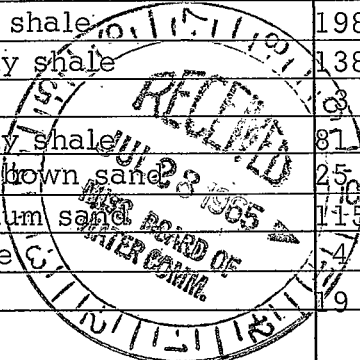

(Use Back Side)

Well No.

