

Junica
 D 20
 7-1-75

MISSISSIPPI
 BOARD OF WATER COMMISSIONERS
 416 North State Street
 Jackson, Mississippi 39201

CODED

WATER WELL DRILLERS LOG

date well completed, 1975 July 1, 1975
 firm name Shelby Neyman
 county well located Junica

LANDOWNER: James Robertson
 Box 4547-38676
 Junica Miss
 (mailing address)

description of formations encountered	from	to
Dark clay	0	20
Sandy	20	75

WELL LOCATION:
 sec 24 T. 4 S R. 11 E 15E
 5 miles NE of Junica
 (distance) (direction) (nearest town)

Clear sand	75	90
------------	----	----

CODED

WELL PURPOSE: Home use
 (home, irrigation, municipal, industrial)

WELL COMPLETION DATA:

(1) diameter (inches) 2

(2) total depth (feet) 90

(3) static water level (feet) 12 below top of ground.

(4) casing Plastic 90 (material) (depth)
 (size) if telescope see back.

(5) screen 10 ft (length) (depth to top)
 2 (size) Plastic (material)

(6) pump 3/4 HP 8 (yield gpm)
 Electric (type power)

(7) electric log no (yes or no)

(organization running log)


(8) how well bottom plugged 2 in Plastic cap

DRILLERS REMARKS:

MISSISSIPPI BOARD OF WATER COMMISSIONERS
 JUNE 13 1975

If well telescopes please sketch and show depths.

GROUND LEVEL

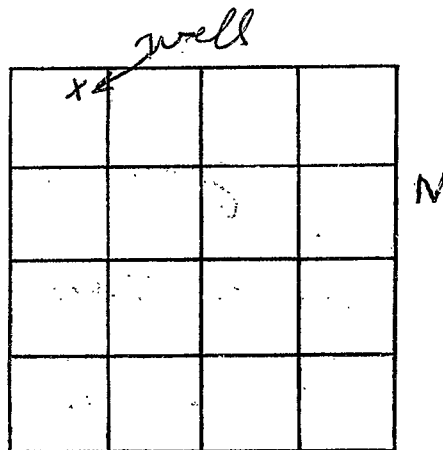

E
SECTION 11

Please indicate well location X.

ADDITIONAL INFORMATION

If more than one screen,
show locations of each on sketch.