

TUNICA
D22
9-27-76

MISSISSIPPI
BOARD OF WATER COMMISSIONERS
416 North State Street
Jackson, Mississippi 39201

CODED

WATER WELL DRILLERS LOG

9-27-76 1976 Hester Drilling Co Tunica
date well completed firm name county well located

LANDOWNER:	description of formations encountered	from	to
TR Swindall Tunica Miss	Clay	0	38
	fine Sand	38	88
(mailing address)	DE COURSE Sand & Gravel + CORN MEAL	88	132
WELL LOCATION:			
sec. 10 T. 4 N. R. 10 E. W. 1/4			
1/4 miles West of Hollywood (distance) (direction) (nearest town)			
WELL PURPOSE: (home, irrigation, municipal, industrial)			
WELL COMPLETION DATA:			
(1) diameter (inches) 16"			
(2) total depth (feet) 132			
(3) static water level (feet) 12 below ground			
(4) casing steel 92 (material) (depth)			
16" if telescope see back. (size)			
(5) screen 40ft 92 (length) (depth to top)			
16" steel (size) (material)			
(6) pump 60 2800 (HP) (yield gpm)			
DIRSK1 (type power)			
(7) electric log NO (yes or no)			
(organization running log)			
(8) how well bottom plugged Plate			
DRILLERS REMARKS:			


CODED

RECEIVED
NOV - 1 1976

MISS. Bd. OF WATER COMMISSIONERS

If well telescopes please sketch and show depths.

GROUND LEVEL

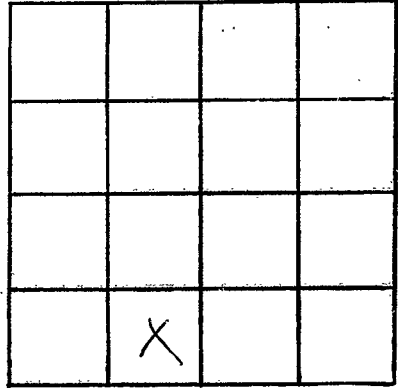

SECTION 10

Please indicate well location X.

ADDITIONAL INFORMATION

If more than one screen, show locations of each on sketch.