

TONICA
 D 75
 4-29-81
 G.W. 6908

MISSISSIPPI
 BOARD OF WATER COMMISSIONERS
 416 North State Street
 Jackson, Mississippi 39201

COPIED

WATER WELL DRILLERS LOG

4-29-81 date well completed
 Hester Drilling Service firm name
 Tunica county well located

LANDOWNER: F.M. Perry
 Tunica, Miss

description of formations encountered	from	to
Hydrus & Clay	0	30
Coarse sand & gravel	30	103

(mailing address)
 WELL LOCATION: 11 W
 sec 5 T 4 N R 13 E
 7 1/2 miles W of Tunica
 (distance) (direction) (nearest town)

WELL PURPOSE: Small
 (home, irrigation, municipal, industrial)

- WELL COMPLETION DATA:
- (1) diameter (inches) 10 in
 - (2) total depth (feet) 103
 - (3) static water level (feet) 12 below top of ground
 - (4) casing Steel 63 (material) (depth)
 - no (size) If telescope see back.
 - (5) screen 40 63 (length) (depth to top)
 - 10 Steel (size) (material)
 - (6) pump 20 1500 (HP) (yield gpm)
 - Diesel (type power)
 - (7) electric log no (yes or no)
 - no (organization running log)
 - (8) how well bottom plugged steel plate


DRILLERS REMARKS: Real Hard formation

DEPT. OF NATURAL RESOURCES
 BUREAU OF LAND & WATER RESOURCES

MAY - 7 1981
 RECEIVED

If well telescopes please sketch and show depths.

GROUND LEVEL

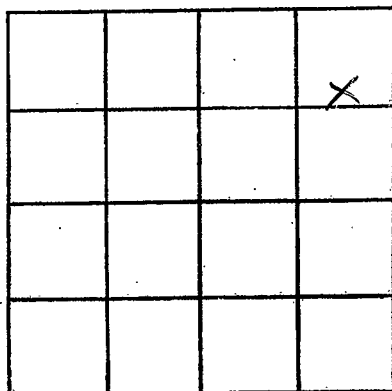

SECTION 4

Please indicate well location X.

ADDITIONAL INFORMATION

If more than one screen, show locations of each on sketch.