

elw - 195'

TUNICA  
D 26  
4-25-81  
GW 6966

MISSISSIPPI  
BOARD OF WATER COMMISSIONERS  
416 North State Street  
Jackson, Mississippi 39201

CODED

WATER WELL DRILLERS LOG

4-25 1981 date well completed  
Hester Drilling firm name  
Tunica county well located

LANDOWNER: Jim Perry  
Tunica, Miss  
(mailing address)

description of formations encountered	from	to
Shale	0	32
Fine sand	32	40
Coarse sand + gravel	40	90

WELL LOCATION:  
sec. 5 T 4 N R 12 E  
6 1/2 miles N West of Tunica  
(distance) (direction) (nearest town)

WELL PURPOSE:  
(home, irrigation, municipal, industrial)

- WELL COMPLETION DATA:
- (1) diameter (inches) 8 in
  - (2) total depth (feet) 90
  - (3) static water level (feet) 12 below top of ground
  - (4) casing Plastic 50 (material) (depth)
  - no if telescope see back. (size)
  - (5) screen 40 50 (length) (depth to top)
  - 8 Plastic (size) (material)
  - (6) pump 15 1100 (HP) (yield gpm)
  - Elect (type power)
  - (7) electric log no (yes or no)
  - no (organization running log)
  - (8) how well bottom plugged Plastic Cap

CODED

DEPT. OF NATURAL RESOURCES  
BUREAU OF LAND & WATER RESOURCES


MAY - 7 1981

RECEIVED

DRILLERS REMARKS:  
Ran out of  
formation cut  
90 ft.

If well telescopes please sketch and show depths.

GROUND LEVEL

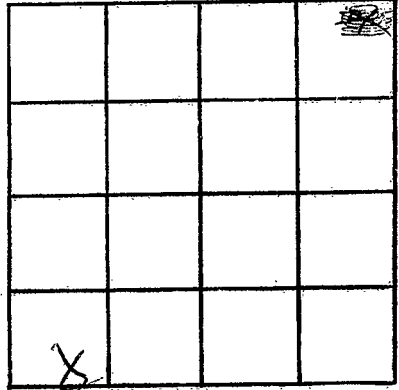

SECTION ~~scribble~~

Please indicate well location X.

ADDITIONAL INFORMATION

If more than one screen, show locations of each on sketch.