

TUNICA
D 27
4-20-81

MISSISSIPPI
BOARD OF WATER COMMISSIONERS
416 North State Street
Jackson, Mississippi 39201

CODED

WATER WELL DRILLERS LOG

4-20 1981 Hester Drilling Tunica
date well completed firm name county well located

LANDOWNER: F.M. Perry
Tunica, Miss
(mailing address)

description of formations encountered	from	to
<u>Shale</u>	<u>0</u>	<u>47</u>
<u>fine sand</u>	<u>47</u>	<u>54</u>
<u>Coarse sand</u>	<u>54</u>	<u>100</u>
<u>+ gravel</u>		

WELL LOCATION:
sec. 4 T. 4 S. R. 11
6 miles N West Tunica
(distance) (direction) (nearest town)

WELL PURPOSE: Dom
(home, irrigation, municipal, industrial)

CODED

- WELL COMPLETION DATA:
- (1) diameter (inches) 8 in
 - (2) total depth (feet) 100
 - (3) static water level (feet) 15 below above top of ground.
 - (4) casing plastic (material) (depth)
 - no if telescope see back. (size)
 - (5) screen 10 60 (length) (depth to top)
 - 8 (size) plastic (material)
 - (6) pump 15 1100 (HP) (yield gpm)
 - Elect (type power)
 - (7) electric log no (yes or no)
 - no (organization running log)
 - (8) how well bottom plugged plastic cap


DRILLERS REMARKS:
Good
formation

DEPT. OF NATURAL RESOURCES
BUREAU OF LAND & WATER RESOURCES

MAY - 7 1981
RECEIVED

If well telescopes please sketch and show depths.

GROUND LEVEL

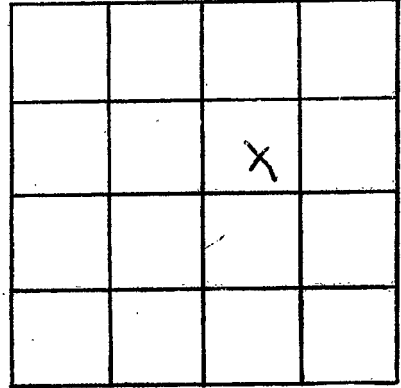

SECTION 4

Please indicate well location X.

ADDITIONAL INFORMATION

If more than one screen,
show locations of each on sketch.