

TONICA
D 28
4-15-81

MISSISSIPPI
BOARD OF WATER COMMISSIONERS
416 North State Street
Jackson, Mississippi 39201

CODED

WATER WELL DRILLERS LOG

4-15 1981 Hester Drilling Junice
date well completed firm name county well located

LANDOWNER: James Peghrow.
Junice, Miss
(mailing address)

description of formations encountered	from	to
Gravel	0	37
Clay Sand	37	44
Coarse Sand & Gravel	44	103

WELL LOCATION:
sec 34 T. 4 N R. 11 E
2 miles East of Junice
(distance) (direction) (nearest town)

CODED

WELL PURPOSE: Irra
(home, irrigation, municipal, industrial)


- WELL COMPLETION DATA:
- (1) diameter (inches) 8 in
 - (2) total depth (feet) 103
 - (3) static water level (feet) 12 below top of ground
 - (4) casing Plastic, 63 (material) (depth)
no (size) if telescope see back.
 - (5) screen 140 (length) 63 (depth to top)
8 (size) Plastic (material)
 - (6) pump 15 (HP) 1100 (yield gpm)
Elect (type power)
 - (7) electric log no (yes or no)
no (organization running log)
 - (8) how well bottom plugged Plastic cap

DRILLERS REMARKS: Red
Good formation

DEPT. OF NATURAL RESOURCES
BUREAU OF LAND & WATER RESOURCES
MAY -7 1981
RECEIVED

If well telescopes please sketch and show depths.

GROUND LEVEL

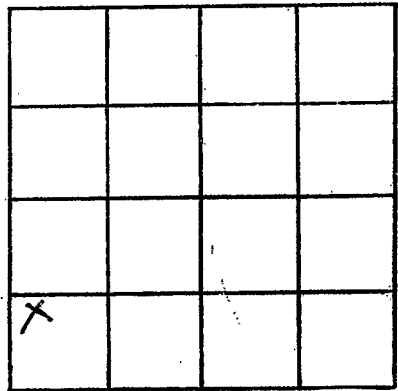

SECTION

34

Please indicate well location X.

ADDITIONAL INFORMATION

If more than one screen,
show locations of each on sketch.