

MISSISSIPPI DEPARTMENT OF NATURAL RESOURCES

Bureau of Land and Water Resources

Southport Mall

P.O. Box 10631

CODED

Jackson, Mississippi 39209

WATER WELL DRILLERS LOG

Jumica  
#D31  
6-21-80

6-21 1980 date well completed  
Hester Drilling firm name  
Jumica county well located

LANDOWNER: AS. Perry  
+ Sons Inc.  
Jumica, Miss  
(mailing address)

description of formations encountered	from	to
Humus + clay fine sand	0	32
Coarse sand gravel	32	54
	54	97

WELL LOCATION:  
sec. 8 T. 4 S. R. 10 W. of Jumica  
1 1/2 miles (distance) NNE (direction) of Jumica (nearest town)

WELL PURPOSE: IYRA  
(home, irrigation, municipal, industrial)

WELL COMPLETION DATA:

- (1) diameter (inches) 16 in
- (2) total depth (feet) 97
- (3) static water level (feet) 15 below top of ground.
- (4) casing Steel 57 (material) (depth)
- N/A (size) if telescope see back.
- (5) screen 40 57 (length) (depth to top)
- 16 Steel (size) (material)
- (6) pump 60 300 HP M (HP) (yield/gpm)
- Diesel (type power)
- (7) electric log no (yes or no)
- (organization running log)
- (8) how well bottom plugged Steel plate

CODED

DRILLERS REMARKS: Rust Drill


DEPT. OF NATURAL RESOURCES  
BUREAU OF LAND & WATER RESOURCES

DEC 10 1981

RECEIVED

If well telescopes please sketch and show depths.

GROUND LEVEL

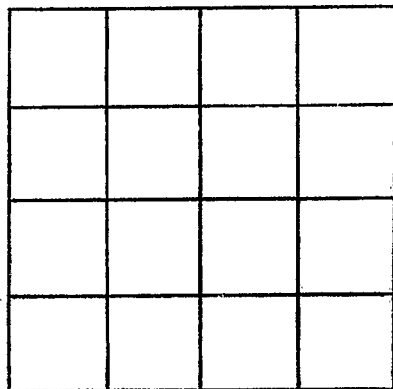

SECTION \_\_\_\_\_

Please indicate well location X.

ADDITIONAL INFORMATION

If more than one screen, show locations of each on sketch.